


STATE OF KANSAS
STATE CORPORATION COMMISSION
200 Colorado Derby Bldg.
Wichita, Kansas 67202

Form CP-4
Rev. 12-15-80

WELL PLUGGING RECORD

Give All Information Completely
Make Required Affidavit

COUNTY Cowley SEC. 24 TWP. 31S RGE. 4 E/W
Location as in quarters or footage from lines:
NW SE NW

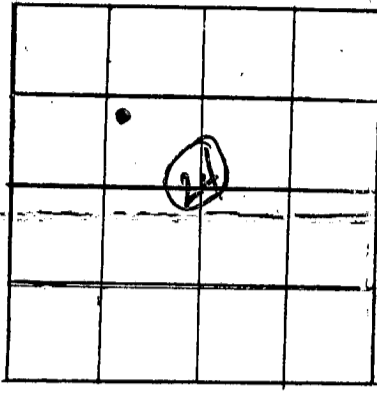

Locate Well
correctly on above
Section Platt.

Lease Owner H.H. Blair Oil Co., Inc. Lic. #7087
Lease Name Gibson Well No. 2
Office Address Rt.1 Box 138, Atlanta, KS 67008
Character of Well (Completed as Oil, Gas or Dry Hole): _____
Date Well Completed 1955
Application for plugging filed _____
Plugging commenced 6/6/83
Plugging completed 6/7/83
Reason for abandonment of well or producing formation _____
Non - use

Was permission obtained from the Conservation Division or it's
Agent's before plugging was commenced? Yes

Name of Conservation Agent who supervised plugging of this well Ron Wilson
Producing formation Bartlesville Depth to top 2884 bottom 2912 T.D. 2966
(-1671) (-1691)

Show depth and thickness of all water, oil and gas formations.

OIL, GAS OR WATER RECORDS

Casing Record

Formation	Content	From	To	Size	Put in	Pulled Out
Layton	Sand-shale	2266	2322		70' 8 5/8"	None
Bartlesville	Sand	2884	2912		2963 5 1/2"	360'
Mississippi	Chty lime	2956	2966(TD)			

Describe in detail the manner in which the well was plugged, indicating where the mud fluid was placed and the method or methods used in introducing it into the hold. If cement or other plugs were used, state the character of same and depth placed, from _____ feet to _____ feet for each plug set.


Steel in hole @ 400', impossible to drill through checked with KCC office to OK building bridge @ 400" Added rock and gravel to steel bridge from 400' to 380' Ripped 5 1/2" @ 360' and laid down. Built bridge of rubber tire and rock from 330' to 320'. Ran open end tubing to 315' and circulated cement (125 sx common w/5% gel) to surface. Pulled tubing, cement fell 20' filled back up with remaining cement. Hole standing full of cement @12:30 pm 6/7/83.

(If additional description is necessary, use BACK of this sheet)

Name of Plugging Contractor Catlett Drilling, Augusta, KS

STATE OF KANSAS COUNTY OF BUTLER, SS. H. H. BLAIR OIL CO., INC. (employee of owner) or (owner or operator) of the above-described well, being first duly sworn on oath, says: That I have knowledge of the facts, statements, and matters herein contained and the log of the above-described well as filed and that the same are true and correct. So help me God. H. H. BLAIR OIL CO., INC.

(Signature) H. H. Blair President
Rt.1 Box 138 Atlanta, KS 67008
(Address)

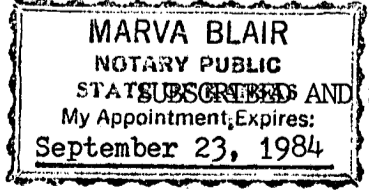

SWORN TO before me this 16th day of June, 19 83

Marva Blair
Notary Public.

My Commission expires: September 23, 1984

RECEIVED
STATE CORPORATION COMMISSION

JUN 20 1983