

STATE OF KANSAS
STATE CORPORATION COMMISSION
130 S. Market, Room 2078
Wichita, KS 67202

WELL PLUGGING RECORD
K.A.R.-82-3-117

15-065-03241-000
API NUMBER 4-001,723

LEASE NAME Elrick Unit

WELL NUMBER 7-4

TYPE OR PRINT
NOTICE: Fill out completely
and return to Cons. Div.
office within 30 days.

 Ft. from S Section Line

 Ft. from E Section Line

SEC. 10 TWP. 10S RGE. 25 (E) or (W)

COUNTY Graham

LEASE OPERATOR Citation Oil & Gas Corporation

ADDRESS 4848 SW 36th Street -Oklahoma City, OK. 73179

PHONE (405) 681-9400 OPERATORS LICENSE NO. 03553

Date Well Completed

Character of Well Oil

Plugging Commenced 5-2-96

(Oil, Gas, D&A, SWD, Input, Water Supply Well)

Plugging Completed 5-2-96

The plugging proposal was approved on (date)

by Hubert Deines (KCC District Agent's Name).

Is ACO-1 filed? If not, is well log attached?

Producing Formation Depth to Top Bottom T.O. 3994'

Show depth and thickness of all water, oil and gas formations.

OIL, GAS OR WATER RECORDS | CASING RECORD

Formation	Content	From	To	Size	Put In	Pulled out
				8 5/8"	165'	none
				5 1/2"	3994'	934'

Describe in detail the manner in which the well was plugged, indicating where the mud fluid placed and the method or methods used in introducing it into the hole. If cement or other plugging materials were used, state the character of same and depth placed, from feet to feet each section. CIBP was at 3700'. Shot casing at 2150' pumped 160 sacks cement with 300# hulls displaced at 2150'. Shot casing at 934' pumped 80 sacks cement, 200# hulls. Pulled up to 200', circulated to surface with 50 sacks cement. Pulled rest of casing. 60/40 10% gel, 1/4# Flo Seal Plugging complete

Name of Plugging Contractor Mike's Testing & Salvage, Inc. License No. 31529

Address P.O. Box 209 Chase, Kansas 67524

NAME OF PARTY RESPONSIBLE FOR PLUGGING FEES: Mike's Testing & Salvage, Inc. -Chase, Ks.

STATE OF Kansas COUNTY OF Rice, ss.

Mike Kelso (Employee of Operator) or (Operator) above-described well, being first duly sworn on oath, says: That I have knowledge of the facts and statements, and matters herein contained and the log of the above-described well as filed to the same are true and correct, so help me God.


(Signature) *Mike Kelso*

(Address) P.O. Box 209 Chase, Kansas 67524

SUBSCRIBED AND SWORN TO before me this 8th day of May, 19 96

Irene Herzberg
Notary Public

My Commission Expires:

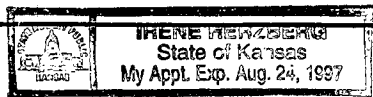


WELL LOG BUREAU—KANSAS GEOLOGICAL SOCIETY
508 East Murdock, Wichita, Kansas

Company. EMPIRE DRILLING CO.
Farm. Mary Dinkel "B" No. 4

SEC. 10 T. 10 R. 25W
NE SE SW

Total Depth. 3995'
Comm. 3-7-58 Comp. 3-17-58
Shot or Treated.
Contractor. Empire Drilg.
Issued. 5-31-58

County Graham
KANSAS

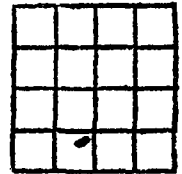

Elevation. 2502' KB

CASING:
8 5/8" 167' cem w/100 sx.
5 1/2" 3994' cem w/75 sx.
D.V. Tool 2176' w/100 barrels of Kempac

Production. 201 BOPD

Figures indicate Bottom of Formations.

sand, clay & shale	198
shale, sand, shells	860
shale & shells	1690
shale, sand, shells	2045
shale & shells	2125
Anhydrite	2160
shale & shells	2870
shale & lime	2950
lime & shale	3050
shale & lime	3165
lime & shale	3760
lime	3805
lime & shale	3815
lime	3995 RTD
Total Depth	

TOPS:
Anhydrite 2125
Heebner 3726
Toronto 3751
Lansing-Kansas City 3768