


Give All Information Completely  
Make Required Affidavit  
Mail or Deliver Report to:  
Conservation Division  
State Corporation Commission  
800 Biting Building  
Wichita, Kansas

WELL PLUGGING RECORD

NORTH

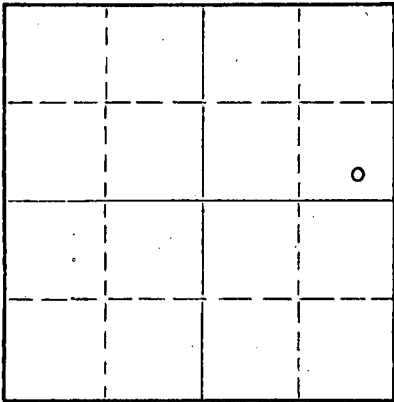

Locate well correctly on above Section Plat

Trego County. Sec. 29 Twp. 12 Rge. 22 (E) W (W)  
Location as "NE/CNWSW" or footage from lines. SE SE NE  
Lease Owner Harms-Burt Drilling Co.  
Lease Name Tawney Well No. 1  
Office Address Box 184, Great Bend, Kansas  
Character of Well (completed as Oil, Gas or Dry Hole) Dry Hole  
Date well completed March 31 1955  
Application for plugging filed March 31 1955  
Application for plugging approved March 31 (orally) 1955  
Plugging commenced March 31 1955  
Plugging completed March 31 1955  
Reason for abandonment of well or producing formation Dry Hole

If a producing well is abandoned, date of last production 19  
Was permission obtained from the Conservation Division or its agents before plugging was commenced? yes

Name of Conservation Agent who supervised plugging of this well Eldon Petty, Box 326, Hays, Kansas  
Producing formation \_\_\_\_\_ Depth to top \_\_\_\_\_ Bottom \_\_\_\_\_ Total Depth of Well 4145 Feet  
Show depth and thickness of all water, oil and gas formations.

OIL, GAS OR WATER RECORDS

CASING RECORD

FORMATION	CONTENT	FROM	TO	SIZE	PUT IN	PULLED OUT
Surface		o	190'	8 5/8"	190'	None

Describe in detail the manner in which the well was plugged, indicating where the mud fluid was placed and the method or methods used in introducing it into the hole. If cement or other plugs were used, state the character of same and depth placed, from \_\_\_\_\_ feet to \_\_\_\_\_ feet for each plug set.

Filled hole with mud from 4145' to 185'  
Set plug at 185' with 15 sacks of cement on top.  
Heavy mud to 40'. Set plug at 40' with 10 sacks cement on top of plug.

(If additional description is necessary, use BACK of this sheet)

Name of Plugging Contractor Harms-Burt Drilling Co.  
Address Box 184, Great Bend, Kansas

STATE OF Kansas, COUNTY OF Barton, ss.  
Allan Harms (employee of owner) or (owner or operator) of the above-described well, being first duly sworn on oath, says: That I have knowledge of the facts, statements, and matters herein contained and the log of the above-described well as filed and that the same are true and correct. So help me God.

(Signature) Allan Harms  
Box 184, Great Bend, Kansas  
(Address)

SUBSCRIBED AND SWORN TO before me this 14 day of April, 1955

Mary E Van Belt  
Notary Public.

My commission expires 1-20-58

PLUGGING  
FILE SEC 29 T 12 R 22  
BOOK PAGE 108 LINE 23

04-15-1955

15-195-00316-00-00

Driller's Log

Company: Harms-Burt Drilling Co.

Farm: Tawney #1 SE SE NE

Sec. 29-12S-22W, Trego County, Kans.

Commenced: March 18, 1955

Completed: March 31, 1955

Elevation: 2399 RB

0- 70	Clay, post rock & sand	2340-2380	Shale & lime
70- 85	Sand & gravel	2380-3643	Lime & shale
85- 190	Shale & shells	3643-3647	Heebner
190- 725	Shale	3647-3680	Lime & shale
725- 1005	Shale & sand	3680-4000	Lime
1005- 1140	Sand	4000-4015	Lime & shale
1140- 1200	Shale & shells	4015-4070	Lime & chert
1200- 1550	Sand shale	4070-4098	Lime
1550-1817	Shale & shells	4098-4137	Conglomerate
1817-1859	Anhydrite	4137-4145	Arbuckle
1859-1864	Shale	4145	T.D.
1864-2340	Shale & shells		

Set 190 feet of 8 5/8" surface pipe cemented with 200 sacks of common cement and 4 sacks of calcium chloride.

Tops: Anhydrite 1817  
 Heebner 3643  
 Lansing KC 3679  
 Conglomerate 4098  
 Arbuckle 4132

Drill Stem Tests: No. 1 4057-95 Open 1 hour, shut in 20 minutes  
75' muddy salt water BHP 1260# FP 0#

Ran Electric Log.

Dry, plugged and abandoned.

Affidavit: State of Kansas )  
County of Barton ) SS.

I, Allan Harms of Harms-Burt Drilling Company, being first duly sworn on oath state: That I have knowledge of the facts, statements, and matters herein contained and that the same are true and correct.

Signed Allan Harms

Subscribed and sworn to before me this 14 day of April, 1955.

Comm. Exp. 1-20-58

Mary E Van Pelt  
Notary Public



RECEIVED BY BUREAU  
APR 15 1955  
TREGO COUNTY, KANSAS

PLUGGING  
FILE SEC 29-12-22W  
BOOK PAGE 108 LINE 23