


WELL PLUGGING RECORD

Give All Information Completely
Make Required Affidavit
Mail or Deliver Report to:
Conservation Division
State Corporation Commission
211 No. Broadway
Wichita, Kansas

NORTH

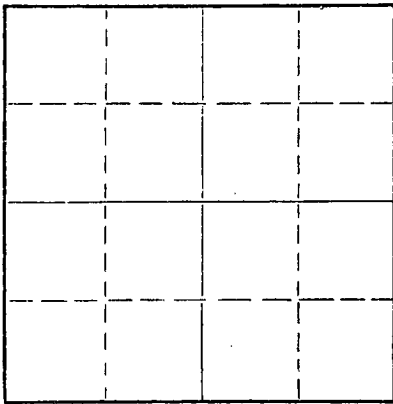

Locate well correctly on above
Section Plat

Trego County. Sec. 29 Twp. 12 Rge. 22 (E) W (W)
Location as "NE/CNW%SW%" or footage from lines NE NE NE
Lease Owner Harms-Burt Drilling Company
Lease Name Tawney Well No. 2
Office Address P. O. Box 184, Great Bend, Kansas
Character of Well (completed as Oil, Gas or Dry Hole) Dry Hole
Date well completed October 8, 1958
Application for plugging filed " 8, 1958
Application for plugging approved " 8, (verbally) 1958
Plugging commenced " 8, 1958
Plugging completed " 8, 1958
Reason for abandonment of well or producing formation Dry Hole

If a producing well is abandoned, date of last production _____ 19____
Was permission obtained from the Conservation Division or its agents before plugging was commenced? Yes

Name of Conservation Agent who supervised plugging of this well Gilbert P. Leiker
Producing formation _____ Depth to top _____ Bottom _____ Total Depth of Well 3945 Feet
Show depth and thickness of all water, oil and gas formations.

OIL, GAS OR WATER RECORDS

CASING RECORD

FORMATION	CONTENT	FROM	TO	SIZE	PUT IN	PULLED OUT
Surface		0	205'	8 5/8"	205'	None

Describe in detail the manner in which the well was plugged, indicating where the mud fluid was placed and the method or methods used in introducing it into the hole. If cement or other plugs were used, state the character of same and depth placed, from _____ feet to _____ feet for each plug set.

Filled hole with heavy mud from total depth to 190' with plug, 1/4 sack of hulls, and 25 sacks of cement at this point. Heavy mud to 40' with plug 1/4 sack hulls and 10 sacks of cement.

RECEIVED
STATE CORPORATION COMMISSION

NOV 4 1958
11-04-1958

Wichita, Kansas

(If additional description is necessary, use BACK of this sheet)
Name of Plugging Contractor Harms-Burt Drilling Company
Address P. O. Box 184, Great Bend, Kansas

STATE OF Kansas, COUNTY OF Barton, ss.
Allan Harms (employee of owner) or (owner or operator) of the above-described well, being first duly sworn on oath, says: That I have knowledge of the facts, statements, and matters herein contained and the log of the above-described well as filed and that the same are true and correct. So help me God.

(Signature) Allan Harms
P. O. Box 184, Great Bend, Kansas
(Address)

SUBSCRIBED AND SWORN TO before me this 1st day of NOVEMBER, 1958

Mary E. Van Pelt
Notary Public.

My commission expires 1-20-62

PLUGGING
FILE SEC 29 T. 12. R. 22W
BOOK PAGE 138 LINE 21

15-195 - 01092-00-00

DRILLERS LOG

Company: Harms-Burt Drilling Company
Farm : Tawney #2
Commenced: September 29, 1958

NE NE NE Sec. 29-12-22W
Trego County, Kansas
Completed: October 8, 1958

Elevation: 2405 KB

0 - 60	post lime
60 - 95	sand
95 - 1000	shale
1000 - 1125	sand
1125 - 1250	shale & sand
1250 - 1500	sand
1500 - 1790	shale
1790 - 1850	anhydrite
1850 - 2335	shale & shells
2335 - 2360	shale
2360 - 3005	lime & shale
3005 - 3130	lime
3130 - 3495	lime & shale
3495 - 3575	lime
3575 - 3627	lime & shale
3627 - 3945	lime
3945	total depth

Set 205' of 8 5/8" surface pipe. Cemented with 175 sacks of common cement and 2% calcium chloride.

Tops: Anhydrite - 1790
 Heebner - 3652
 Lansing KC - 3686

Drill Stem Tests: #1 3725-3765 Open 1 hour - Shut in 20 min. Recovered 200' water. IBHP-1352# FBHP-1112#
 #2 3765-3798 Open 1 hour - Shut in 20 min. Recovered 650' of Salt Water. IBHP-1210# FBHP-1140#

Dry, plugged and abandoned.

AFFIDAVIT

RECEIVED
STATE CORPORATION COMMISSION

STATE OF KANSAS)
) SS.
COUNTY OF BARTON)

NOV 4 1958
11-4-1958
CONSERVATION DIVISION
Wichita, Kansas

I, Allan Harms of the Harms-Burt Drilling Company being first duly sworn on oath state: I have knowledge of the facts, statements and matters herein contained and the same are true and correct.

Allan Harms

Subscribed and sworn to before me this 1ST day of NOVEMBER 1958.

Mary E. Van Pelt
Notary Public

My commission expires, 1-20-62

PLUGGING
FILE SEC. <u>29</u> T. <u>12</u> R. <u>22W</u>
BOOK PAGE <u>130</u> LINE <u>21</u>