


15-195-20656-00-00

STATE OF KANSAS  
STATE CORPORATION COMMISSION

Form CP-4

Give All Information Completely  
Make Required Affidavit  
Mail or Deliver Report to:  
Conservation Division  
State Corporation Commission  
P. O. Box 17027  
Wichita, Kansas 67217  
NORTH

WELL PLUGGING RECORD

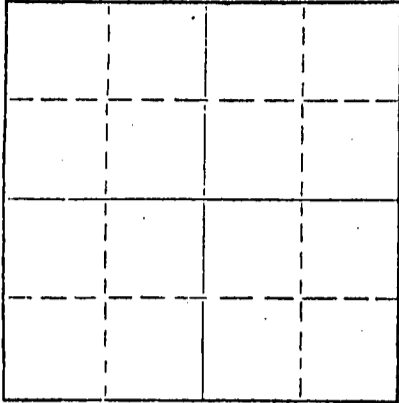

Locate well correctly on above  
Section Plat

Trego County, Sec. 29 Twp. 12S Rge. (E) 22W(W)  
Location as "NE/CNWxSWx" or footage from lines. C NW SE NE  
Lease Owner Chief Drilling Co., Inc.  
Lease Name Smith Well No. #1  
Office Address 905 Century Plaza, Wichita, Kansas 67202  
Character of Well (completed as Oil, Gas or Dry Hole) dry hole  
Date well completed June 7, 1980 19  
Application for plugging filed June 7, 1980 19  
Application for plugging approved June 7, 1980 19  
Plugging commenced June 7, 1980 19  
Plugging completed June 7, 1980 19  
Reason for abandonment of well or producing formation dry hole

If a producing well is abandoned, date of last production 19  
Was permission obtained from the Conservation Division or its agents before plugging was commenced? Yes

Name of Conservation Agent who supervised plugging of this well Gilbert Balthazor  
Producing formation \_\_\_\_\_ Depth to top \_\_\_\_\_ Bottom \_\_\_\_\_ Total Depth of Well 4153' Feet  
Show depth and thickness of all water, oil and gas formations.


OIL, GAS OR WATER RECORDS

CASING RECORD

FORMATION	CONTENT	FROM	TO	SIZE	PUT IN	PULLED OUT
				8 5/8"	213'	-0-

Describe in detail the manner in which the well was plugged, indicating where the mud fluid was placed and the method or methods used in introducing it into the hole. If cement or other plugs were used, state the character of same and depth placed, from \_\_\_\_\_ feet to \_\_\_\_\_ feet for each plug set.

Plugged w/70 sx. @ 1000', 20 sx. @ 200',  
10 sx. @ 40' & 5 sx. in rathole.

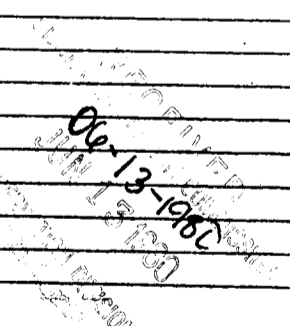

(If additional description is necessary, use BACK of this sheet)  
Name of Plugging Contractor Chief Drilling Co., Inc.  
Address 905 Century Plaza, Wichita, Kansas 67202

STATE OF KANSAS, COUNTY OF SEDGWICK, ss.  
Bill G. Lahar (employee of owner) or (owner or operator) of the above-described

well, being first duly sworn on oath, says: That I have knowledge of the facts, statements, and matters herein contained and the log of the above-described well as filed and that the same are true and correct. So help me God.

(Signature) Bill G. Lahar  
905 Century Plaza, Wichita, Ks. 67202  
(Address)

SUBSCRIBED AND SWORN TO before me this 12th day of June, 19 80

Marilyn Sinard  
Marilyn Sinard Notary Public.

MARILYN SINARD  
STATE NOTARY PUBLIC  
SEDGWICK COUNTY, KANSAS  
MY APPT. EXP. 4-30-83

My commission expires \_\_\_\_\_

WELL LOG

15-195-20656-00-00

CHIEF DRILLING CO., INC.  
905 Century Plaza  
Wichita, Kansas 67202

#1 SMITH  
C NW SE NE Sec. 29-12S-22W  
Trego County, Kansas

CONTRACTOR: Warrior Drilling, Inc.  
CASING RECORD: 8 5/8" @ 213' w/140 sx.

COMMENCED: May 29, 1980  
COMPLETED: June 7, 1980

FORMATION	FROM	TO	ELEVATIONS
Surface Sand & Clay	0	217	2408 Gr.
Clay & Sand	217	1135	2410 D.F.
Sand & Shale	1135	1814	2413 K.B.
Anhydrite	1814	1857	
Shale	1857	2496	
Shale & Lime	2496	3288	
Lime & Shale	3288	3748	
Shale & Lime	3748	3989	
Lime	3989	4153	
RTD	4153		

STATE OF KANSAS, COUNTY OF SEDGWICK) ss:

I hereby certify that the above is a true and correct copy of the Driller's Log of the well drilled in the C NW SE NE Sec. 29-12S-22W, Trego County, Kansas, to the best of my knowledge and belief.

CHIEF DRILLING CO., INC.

Bill G. Lahar, Vice President

Subscribed and sworn to before me this 12th day of June, 1980

MARILYN SINARD  
STATE NOTARY PUBLIC  
SEDGWICK COUNTY, KANSAS  
MY APPT. EXP. 4-30-83

*Marilyn Sinard*  
Marilyn Sinard Notary Public

RECEIVED  
JUN 13 1980  
06-13-1980  
REGISTRATION DIVISION  
KANSAS