


WELL PLUGGING RECORD

Give All Information Completely  
Make Required Affidavit  
Mail or Deliver Report to:  
Conservation Division  
State Corporation Commission  
211 No. Broadway  
Wichita, Kansas

Graham County. Sec. 15 Twp. 10S Rge. (E) 25 (W)  
Location as "NE/CNW/SW" or footage from lines SW SE NW  
Lease Owner Herndon Drilling Company  
Lease Name Knoll Well No. 3  
Office Address Drawer 489, Tulsa, Oklahoma  
Character of Well (completed as Oil, Gas or Dry Hole) Dry Hole  
Date well completed 3-1-59 19  
Application for plugging filed 3-1-59 19  
Application for plugging approved 3-1-59 19  
Plugging commenced 3-2-59 19  
Plugging completed 3-2-59 19  
Reason for abandonment of well or producing formation \_\_\_\_\_

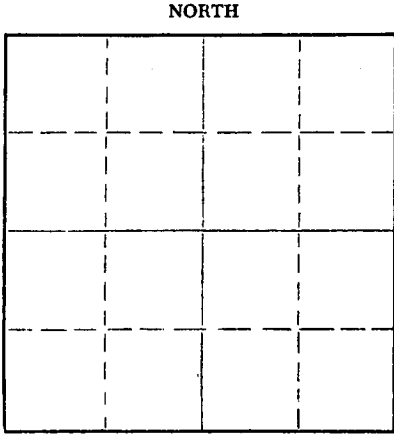

Locate well correctly on above Section Plat

If a producing well is abandoned, date of last production \_\_\_\_\_ 19  
Was permission obtained from the Conservation Division or its agents before plugging was commenced? Yes

Name of Conservation Agent who supervised plugging of this well Mr. A. D. Fabricius, Hill City, Kansas  
Producing formation \_\_\_\_\_ Depth to top \_\_\_\_\_ Bottom \_\_\_\_\_ Total Depth of Well 4020 Feet  
Show depth and thickness of all water, oil and gas formations.

OIL, GAS OR WATER RECORDS

CASING RECORD

FORMATION	CONTENT	FROM	TO	SIZE	PUT IN	PULLED OUT

Describe in detail the manner in which the well was plugged, indicating where the mud fluid was placed and the method or methods used in introducing it into the hole. If cement or other plugs were used, state the character of same and depth placed, from 40 feet to 600 feet for each plug set.

Hole was filled to 600 ft. w/Rotary Mud. Bottom plug set @600 ft. and 20 sx. cement on plug. Hole filled to 200 ft., plug set and 20 sx. cement on plug. Hole filled to 40 ft., plug set and 10 sx. cement. Cement on 600, 200 and 40 ft. plugs. Was pumped thru drill pipe.

RECEIVED  
STATE CORPORATION COMMISSION  
MAR 24 1959  
CONSERVATION DIVISION  
Wichita, Kansas

(If additional description is necessary, use BACK of this sheet)  
Name of Plugging Contractor Herndon Drilling Company (by Halliburton Oil Well Cementing Co.)  
Address Drawer 489, Tulsa, Oklahoma

STATE OF Oklahoma, COUNTY OF Tulsa, ss.  
Tom Elliott (employee of owner) or (owner or operator) of the above-described well, being first duly sworn on oath, says: That I have knowledge of the facts, statements, and matters herein contained and the log of the above-described well as filed and that the same are true and correct. So help me God.

(Signature) Tom Elliott  
2807 Meadowlark Lane, Great Bend, Kansas  
(Address)

SUBSCRIBED AND SWORN TO before me this 23rd day of March, 1959

My commission expires June 19, 1961

Johnnie Alene Frese  
Johnnie Alene Frese Notary Public.

PLUGGING  
FILE SEC. 15 T. 10 R. 25w  
BOOK PAGE 23 LINE 38

# WELL LOG

Well: KNOLL NO. 3  
 Owner: Herndon Drilling Company

Spudding date: 2-20-59  
 Date casing set: 2-21-59  
 Date rotary completed: 3-2-59  
 Date cable completed:

<u>FROM</u>	<u>TO</u>	<u>FORMATION</u>	<u>REMARKS</u>
0	130	Surface Hole	Ran 5 Joints of new 8-5/8" 22.8# Spiral Weld Casing. Set at 203'. Cemented w/160 sx. Common Cement w/2% CC.
130	203	Shale	
203	2155	Shale and Shells	
2155	2345	Shale	
2345	3735	Lime and Shale	
3735	4020	Lime	Hole was filled to 600' and bottom plug set @600' and 20 sx. cement. Second plug @ 200' and 20 sx. Third plug @ 40' and 10 sx.
	4020	T. D.	

**RECEIVED**  
 STATE CONSERVATION COMMISSION  
 MAR 13 1959  
 CONSERVATION DIVISION

Subscribed and sworn to before me this 11th  
 day of March, 19 59

I certify the above and foregoing to be a true and exact copy  
 of the original driller's log on the KNOLL NO. 3

*Johanna Gene Reese*  
 Notary Public

My commission expires:  
 June 19, 1961

HERNDON DRILLING COMPANY  
*C J Moore*  
 By: \_\_\_\_\_  
 Title: Assistant Secretary

**PLUGGING**  
 FILE SEC. 15 T. 10 R. 25w  
 BOOK PAGE 23 LINE 38