


Give All Information Completely
Make Required Affidavit
Mail or Deliver Report to:
Conservation Division
State Corporation Commission
212 No. Market
Wichita, Kansas

WELL PLUGGING RECORD

Trego County, Sec. 34 Twp. 12 Rge. (E) 22 (W)

Location as "NE/CNW%SW%" or footage from lines C NE/4 NE/4
Lease Owner Pan American Petroleum Corporation
Lease Name R. M. Anderson "C" Well No. 1
Office Address Box 432, Liberal, Kansas 67901
Character of Well (completed as Oil, Gas or Dry Hole) Oil
Date well completed September 4 1952
Application for plugging filed July 1 1969
Application for plugging approved July 2 1969
Plugging commenced July 23 1969
Plugging completed July 23 1969
Reason for abandonment of well or producing formation All Known Productive zones depleted
If a producing well is abandoned, date of last production 12-9 1968
Was permission obtained from the Conservation Division or its agents before plugging was commenced? Yes

NORTH

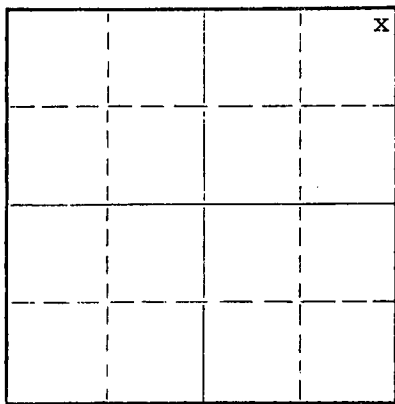

Locate well correctly on above Section Plat

Name of Conservation Agent who supervised plugging of this well Mr. W. L. Nichols
Producing formation Arbuckle Depth to top 3986 Bottom 4025 Total Depth of Well 4065 Feet
Show depth and thickness of all water, oil and gas formations.

OIL, GAS OR WATER RECORDS

CASING RECORD

FORMATION	CONTENT	FROM	TO	SIZE	PUT IN	PULLED OUT
Arbuckle	Oil	3986	4025	8-5/8"	192	0
				5-1/2"	4096	0

Describe in detail the manner in which the well was plugged, indicating where the mud fluid was placed and the method or methods used in introducing it into the hole. If cement or other plugs were used, state the character of same and depth placed, from _____ feet to _____ feet for each plug set.

75 sack cement plug 3910-3500'
Heavy mud 3500- 900'
50 sack cement plug 900- 500'
Heavy mud 500- 50'
5 sack cement plug 50-surface

RECEIVED
STATE CORPORATION COMMISSION
JUL 29 1969
07-29-1969
CONSERVATION DIVISION
Wichita, Kansas

(If additional description is necessary, use BACK of this sheet)

Name of Plugging Contractor Shirk Well Service
Address Ellis, Kansas


STATE OF Kansas, COUNTY OF Seward, ss.
J. W. Vaughn (employee of owner) or (owner or operator) of the above-described well, being first duly sworn on oath, says: That I have knowledge of the facts, statements, and matters herein contained and the log of the above-described well as filed and that the same are true and correct. So help me God.

(Signature) J. W. Vaughn
P. O. Box 432, Liberal, Kansas 67901
(Address)

Subscribed and Sworn to before me this 28 day of July, 19 69.

February 11, 1972

Notary Public.

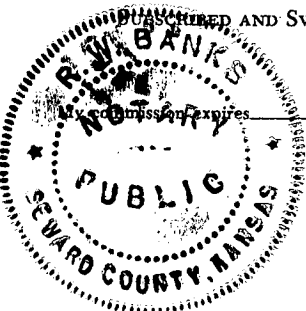

FORMATION RECORD

DESCRIBE EACH FORMATION DRILLED. INDICATE THICKNESS, CONTENT AND WHETHER DRY, OR OIL, GAS, OR WATER BEARING.

FORMATION	TOP	BOTTOM	FORMATION	TOP	BOTTOM
Surface clay, sand and shale	0	196			
Shale and shells	196	220			
Gray shale	220	640			
Gray shale and shells--	640	810			
Shale and sand	810	900			
Shale and shells	900	980			
Sand	980	1045			
Shale and shells	1045	1240			
Sand and shale	1240	1520			
Red bed, shale and shells	1520	1722			
Anhydrite	1722	1768			
Shale and shells	1768	1800			
Shale and shell - red bed	1800	2020			
Shale and lime	2020	3325			
Lime and shale	3325	3600			
Lime	3600	3885			
Lime and shale	3885	3925			
Lime and shale chert	3925	3937			
Lime, shale and chert	3937	3990			
Lime and chert	3990	4045			
Sand, lime and chert	4045	4065			
T. D.		4065			
Date first work: 8-10-52					
Date spudded: 8-11-52					
Date completed: 9-4-52					
DST #1, 3983-95'					
Tool open 1 hr., rec 600' sl and cut oil, BHP 1095#, FFP 332#.					
DST #2, 3995-4032'					
Tool open 30 min., rec 3120' oil, BHP 1122#, FFP 1100#.					
DST #3, 4032-4065'					
Tool open 30 min., rec 2550' SW, BHP 1150#, FFP 1150.					
Perforate 3988-4025', 4 holes per ft.					
Perm. bench mark 6.60' above 2 nd outlet in 6-5/8" Bradenhead.					