


STATE OF KANSAS
STATE CORPORATION COMMISSION

15-195-00070-00-00

WELL PLUGGING RECORD

Give All Information Completely
Make Required Affidavit
Mail or Deliver Report to:
Conservation Division
State Corporation Commission
800 Bitting Building
Wichita, Kansas

Trego County, Sec. 34 Twp. 12S Rge. (E) 22 (W)
Location as "NE/CNW/SW" or footage from lines NE NE NW ANB KCC
Lease Owner Braden Drilling Co.
Lease Name Deutscher Well No. 1
Office Address 802 Union National Bank Bldg.
Character of Well (completed as Oil, Gas or Dry Hole) Dry
Date well completed 6-23-53 19
Application for plugging filed 6-22-53 19
Application for plugging approved 6-22-53 19
Plugging commenced 6-23-53 19
Plugging completed 6-23-53 19
Reason for abandonment of well or producing formation non-productive

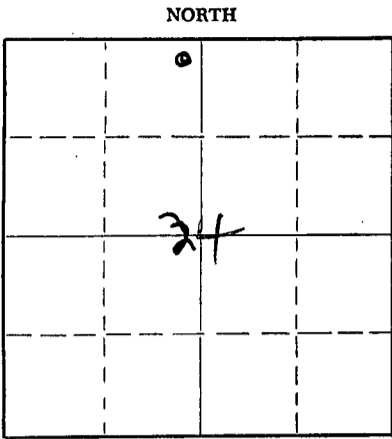

Locate well correctly on above
Section Plat

If a producing well is abandoned, date of last production _____ 19
Was permission obtained from the Conservation Division or its agents before plugging was commenced? yes

Name of Conservation Agent who supervised plugging of this well Elden Petty
Producing formation not producing Depth to top _____ Bottom _____ Total Depth of Well 3840 Feet
Show depth and thickness of all water, oil and gas formations.

OIL, GAS OR WATER RECORDS

CASING RECORD

| FORMATION | CONTENT | FROM | TO | SIZE | PUT IN | PULLED OUT |
|-----------|---------|------|-----|-------|--------|------------|
| | | 0 | 215 | 8-5/8 | 215 | none |
| | | | | | | |
| | | | | | | |
Describe in detail the manner in which the well was plugged, indicating where the mud fluid was placed and the method or methods used in introducing it into the hole. If cement or other plugs were used, state the character of same and depth placed, from _____ feet to _____ feet for each plug set.

Filled hole with heavy mud to within 200' where bottom hole was set. Dumped 1/2 sack hulls and 15 sacks cement. Filled hole to 40' where top plug was set. Dumped 1/2 sack hulls and 10 sacks cement. Cellar filled with top soil.

(If additional description is necessary, use BACK of this sheet)

Name of Plugging Contractor Braden Drilling Co.
Address 802 Union National Bank Bldg., Wichita, Kansas

STATE OF Kansas, COUNTY OF Sedgwick, ss.
Louis E. Potuckk (employee of owner) or (owner or operator) of the above-described well, being first duly sworn on oath, says: That I have knowledge of the facts, statements, and matters herein contained and the log of the above-described well as filed and that the same are true and correct. So help me God.

(Signature) Louis E. Potuckk
802 Union National Bank Bldg., Wichita
(Address)

SUBSCRIBED AND SWORN to before me this 26th day of June, 1953

My commission expires April 29, 1957

24-2675-S 2-52-20M



Norman Richey Notary Public.

RECEIVED
STATE CORPORATION COMMISSION

JUN 27 1953
06-27-1953
CONSERVATION DIVISION
Wichita, Kansas



15-195-00070-0000

DEUTSCHER #1

34-12S-22W

Operator: Braden Drilling Company

NE NE NW

Trego County, Kansas

Contractor: Braden Drilling Company

Elevation: 2360 D.F.

Test Commenced: 6-13-53

Test Completed: 6-22-53

Casing Record: Ran 215' of 8-5/8 casing. Cemented with 135 sacks of cement, 1 sack calcium chloride.

| | |
|-----------------------|---------------|
| Surface Clay & Gravel | 60 |
| Sand & Shale | 105 |
| Shale & Chalky Lime | 215 |
| Chalk & Lime | 270 |
| Shale & Shells | 540 |
| Shale | 690 |
| Sand | 810 |
| Shale & Shells | 990 |
| Sand | 1335 |
| Red Bed & Shale | 1570 |
| Red Bed | 1795 |
| Anhydrite | 1840 |
| Red Bed & Shale | 2040 |
| Shale & Shells | 2205 |
| Shale | 2475 |
| Lime & Shale | 2710 |
| Broken Lime | 2815 |
| Shale & Lime | 2990 |
| Shale | 3270 |
| Shale & Lime | 3475 |
| Lime | 3790 |
| Cherty Lime | 3860 T.D.R.B. |

STATE OF KANSAS,) (SS:-
SEDGWICK COUNTY,)

I hereby certify that the above information is true and correct as revealed by the records of the Braden Drilling Co.

Norma Ribey

Subscribed and sworn to before me this 25th day of June, 1953.

Wm. E. Patneck
Notary Public

My commission expires: Feb. 13, 1954.



RECEIVED
STATE CORPORATION COMMISSION
JUN 27 1953
06-27-1953
CONSERVATION DIVISION
Wichita, Kansas