

CARD MUST BE TYPED

NOTICE OF INTENTION TO DRILL

CARD MUST BE SIGNED

State of Kansas

15-065-22085-00-00

CORRECTION

CORRECTED INTENT (see rules on reverse side)

CORRECTED INTENT

10-22-84

Starting Date: 10 19 84 month day year

API Number 15-065-22,085

OPERATOR: License # 5205

\* N 1/2 S 1/2 SE 1/4 Sec 20 Twp 10 S Rge 25 East West

Name Mid-Continent Energy Corp.

Address 120 S. Market, #712

City/State/Zip Wichita, KS 67202

Contact Person Jack N. Buehler

Phone 316-265-9501

990 Ft North from Southeast Corner of Section

\* 1320 Ft West from Southeast Corner of Section

(Note: Locate well on Section Plat on reverse side)

CONTRACTOR: License # 5110

Name B & B Drilling, Inc.

City/State Wichita, KS 67202

Nearest lease or unit boundary line 990 feet.

County Graham

Lease Name Schamberger Well# 3

Domestic well within 330 feet: [ ] yes [X] no

Municipal well within one mile: [ ] yes [X] no

Well Drilled For: Well Class: Type Equipment:

- [X] Oil [ ] Swd [ ] Infield [X] Mud Rotary
[ ] Gas [ ] Inj [X] Pool Ext. [ ] Air Rotary
[ ] OWWO [ ] Expl [ ] Wildcat [ ] Cable

Depth to Bottom of fresh water 102 feet

Lowest usable water formation Dakota

Depth to Bottom of usable water 1275 feet

Surface pipe by Alternate: 1 [ ] 2 [X]

Surface pipe to be set 250 feet

Conductor pipe if any required feet

Ground surface elevation feet MSL

This Authorization Expires 4-10-85

Approved By 10-10-84

If OWWO: old well info as follows:

Operator

Well Name

Comp Date Old Total Depth

Projected Total Depth 4100 feet

Projected Formation at TD Lansing-Kansas City

Expected Producing Formations Lansing-Kansas City

I certify that we will comply with K.S.A. 55-101, et seq., plus eventually plugging hole to K.C.C. specifications. \*was: NBSEUSE 1650 FEL

Date 10/18/84 Signature of Operator or Agent


[Handwritten Signature]

Title Exploration Manager

Must be filed with the K.C.C. five (5) days prior to commencing well  
This card void if drilling not started within six (6) months of date received by K.C.C.

**Important procedures to follow :**

**A Regular Section of Land  
1 Mile = 5,280 Ft.**

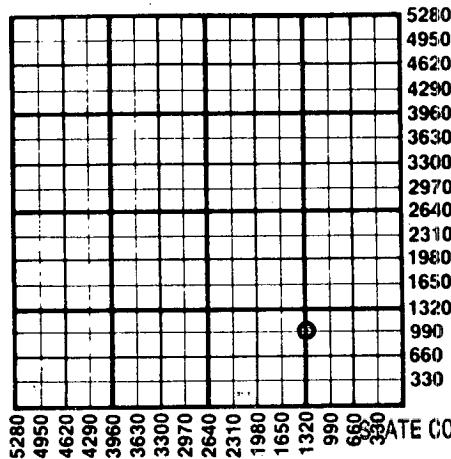

1. Notify District office before setting surface casing.
2. Set surface casing by circulating cement to the top.
3. File completion forms ACO-1 with K.C.C. within 90 days of well completion, following instructions on ACO-1, side 1, and including copies of wireline logs.
4. Notify District office 48 hours prior to old well workover or re-entry.
5. Prior to plugging, prepare a plugging plan, then obtain agreement from the appropriate district office for an approved plugging plan.
6. Submit plugging report (CP-4) to K.C.C. after plugging is completed.
7. Obtain an approved injection docket number before disposing of salt water.
8. Notify K.C.C. within 10 days when injection commences or terminates.
9. If an alternate 2 completion, cement in the production pipe from below any usable water to surface within 120 days of spud date.

RECEIVED

STATE CORPORATION COMMISSION

10-19-1984

OCT 19 1984

CONSERVATION DIVISION  
Wichita, Kansas

State Corporation Commission of Kansas  
Conservation Division  
200 Colorado Derby Building  
Wichita, Kansas 67202  
(316) 263-3238