


STATE OF KANSAS
STATE CORPORATION COMMISSION

Give All Information Completely
Make Required Affidavit
Mail or Deliver Report to:
Conservation Division
State Corporation Commission
211 No. Broadway
Wichita, Kansas

WELL PLUGGING RECORD

Graham County. Sec. 22 Twp. 10S Rge. (E) 25 (W)

Location as "NE/CNW/SW" or footage from lines SW SW NW
Lease Owner Herndon Drilling Company
Lease Name Brungardt "A" Well No. 1
Office Address Drawer 489, Tulsa, Oklahoma
Character of Well (completed as Oil, Gas or Dry Hole) Dry Hole
Date well completed 2-23-60 19 60
Application for plugging filed 2-23 19 60
Application for plugging approved 2-23 19 60
Plugging commenced 2-23 19 60
Plugging completed 2-24 19 60
Reason for abandonment of well or producing formation _____

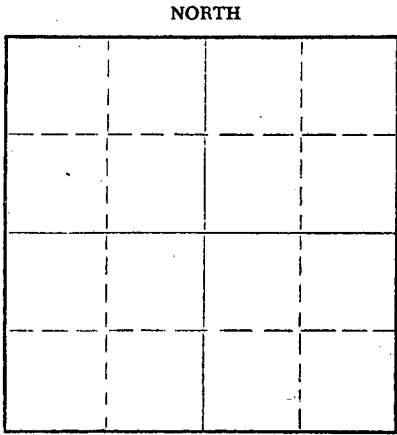

Locate well correctly on above Section Plat

If a producing well is abandoned, date of last production _____ 19 _____
Was permission obtained from the Conservation Division or its agents before plugging was commenced? Yes

Name of Conservation Agent who supervised plugging of this well A. D. Fabricius, Hill City, Kansas
Producing formation _____ Depth to top _____ Bottom _____ Total Depth of Well 4071 Feet
Show depth and thickness of all water, oil and gas formations.

OIL, GAS OR WATER RECORDS

CASING RECORD

FORMATION	CONTENT	FROM	TO	SIZE	PUT IN	PULLED OUT

Describe in detail the manner in which the well was plugged, indicating where the mud fluid was placed and the method or methods used in introducing it into the hole. If cement or other plugs were used, state the character of same and depth placed, from _____ feet to _____ feet for each plug set.


Hole was filled with Rotary Mud to 400 ft. Plug set and 20 sacks cement was mixed and pumped thru drill pipe. Hole filled to 200 ft. plug set and bridged with hulls. 20 sacks cement was pumped thru drill pipe. Hole filled to 40 ft. plug set and bridged. 10 sacks cement was pumped in hole to bottom of cellar.

RECEIVED
STATE CORPORATION COMMISSION
3-11-1960
MAR 11 1960
CONSERVATION DIVISION
Wichita, Kansas

(If additional description is necessary, use BACK of this sheet)
Name of Plugging Contractor Globe Cementing Company, Hill City, Kansas
Address _____

STATE OF OKLAHOMA, COUNTY OF TULSA, ss.
Tom Elliott (employee of owner) or (owner or operator) of the above-described well, being first duly sworn on oath, says: That I have knowledge of the facts, statements, and matters herein contained and the log of the above-described well as filed and that the same are true and correct. So help me God.

(Signature) Tom Elliott
Great Bend, Kansas

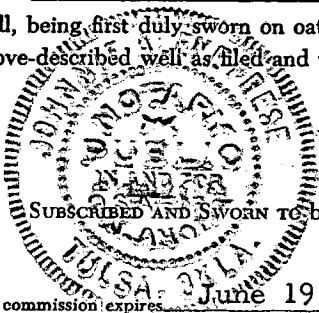

SUBSCRIBED AND SWORN TO before me this 29th day of February, 19 60
Johnnie Alene Freese
Notary Public.

My commission expires June 19, 1961

15-065-00633-00-00

WELL LOG BUREAU—KANSAS GEOLOGICAL SOCIETY
508 East Murdock, Wichita, Kansas


COPY

Company. HERNDON DRILLING COMPANY
Farm. Brungardt "A" No. 1

SEC. 22 T. 10 R. 25W
SW SW NW

Total Depth. 4071'
Comm. 2-14-60 Comp. 2-24-60
Shot or Treated.
Contractor.
Issued. 4-16-60

County Graham
KANSAS

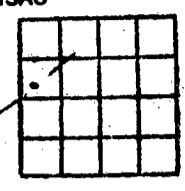

Elevation. 2354'

Production. DRY

CASING:

8 5/8" 202" cem. w/150 sx.

Figures indicate Bottom of Formations.

surface hole	202
shale & shells	1570
shale & lime	1950
shale & shells	2185
anhydrite	2195
lime & shale	2950
lime	3060
lime & shale	3590
lime	3670
lime & shale	3745
lime	4071RTD
lime	4080
Total Depth	
TOPS: SCOUT	
Heebner	3793
Toronto	3815
Kansas City	3830

RECEIVED
STATE CORPORATION COMMISSION
7-16-1964
JUL 16 1964
CONSERVATION DIVISION
Wichita, Kansas