

15-065-02056-0000

Form CP-4

STATE OF KANSAS
STATE CORPORATION COMMISSION

WELL PLUGGING RECORD

Give All Information Completely
Make Required Affidavit
Mail or Deliver Report to:
Conservation Division
State Corporation Commission
211 No. Broadway
Wichita, Kansas

Graham County, Sec. 24 Twp. 10S Rge. 25W (E) (W)

Location as "NE/CNW/SW" or footage from lines SE SE NW

Lease Owner C-G Drilling Co.

Lease Name Knoll #3 Well No. 2 RTKLL

Office Address 107 Rule Building, Wichita, Kansas

Character of Well (completed as Oil, Gas or Dry Hole) D & A

Date well completed November 16 19 62

Application for plugging filed November 16 19 62

Application for plugging approved November 16 19 62


Plugging commenced November 16 19 62

Plugging completed November 16 19 62

Reason for abandonment of well or producing formation Too low structurally

If a producing well is abandoned, date of last production 19

Was permission obtained from the Conservation Division or its agents before plugging was commenced? Yes

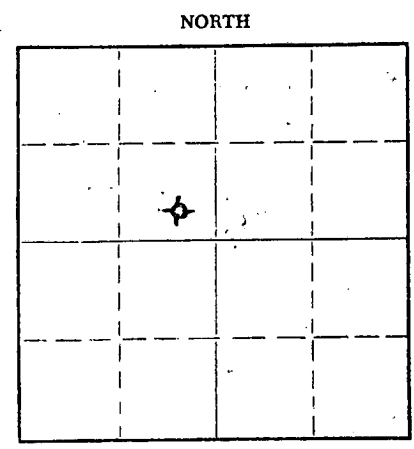

Locate well correctly on above Section Plat

Name of Conservation Agent who supervised plugging of this well Eldon Petty, Hays, Kansas

Producing formation Depth to top Bottom Total Depth of Well 4020 Feet

Show depth and thickness of all water, oil and gas formations.

OIL, GAS OR WATER RECORDS

CASING RECORD

FORMATION	CONTENT	FROM	TO	SIZE	PUT IN	PULLED OUT
				8-5/8"	175.92'	None

Describe in detail the manner in which the well was plugged, indicating where the mud fluid was placed and the method or methods used in introducing it into the hole. If cement or other plugs were used, state the character of same and depth placed, from feet to feet for each plug set.

Filled hole with heavy mud to 550'. Set plug.
Put in 20 Sacks cement. Filled with heavy mud to 175'. Set plug. Put in 20 sacks cement. Filled with heavy mud to 40'. Set plug. Filled to top with 10 sacks cement.

RECEIVED
STATE CORPORATION COMMISSION
11-26-62
NOV 26 1962
CONSERVATION DIVISION
WICHITA, KANSAS

(If additional description is necessary, use BACK of this sheet)

Name of Plugging Contractor C-G Drilling Co.
Address 107 Rule Building, Wichita 2, Kansas


STATE OF KANSAS, COUNTY OF Sedgwick, ss.
G.F. Galloway (employee of owner) or (owner or operator) of the above-described

well, being first duly sworn on oath, says: That I have knowledge of the facts, statements, and matters herein contained and the log of the above-described well as filed and that the same are true and correct. So help me God.

(Signature) G.F. Galloway

107 Rule Building (Address)

Subscribed and Sworn to before me this 16 day of November, 19 62

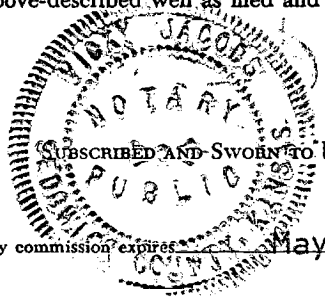

Vicky Jacobs Notary Public.

My commission expires May 20, 1963

15-065-02056-0000

WELL LOG

OPERATOR C-G Drilling Co. SEC. 24-10S-25W
WELL NAME Knoll #3 LOC. SE SE NW
TOTAL DEPTH 4020 COUNTY Graham
COMM. 11/5/62 COMP. 11/16/62 STATE Kansas
RIG NO. 2 ELEVATION 2468 K.B.
CASING: Set 175.92' (5 jts.) 8-5/8" Od Surface Casing. PRODUCTION: D & A

All measurements taken from the top of rotary bushing.

FROM	TO	FORMATION	DEVIATION FROM VERTICAL	REMARKS:
0	175	Shale-Sand		
175	750	Shale	700' - 0°	
750	1880	Shale-Sand	1490' - 0°	
1880	2125	Shale	2000' - 0°	
2125	2167	Anhydrite		
2167	2320	Shell & Shale		
2320	2450	Lime-Shale	2450' - 0°	
2450	2590	Shale-Shell		
2590	2765	Shale-Lime		
2765	3665	Lime-Shale	3050' - 0°	
3665	3715	Lime	3680' - 0°	
3715	3790	Lime-Shale		DST #1 3771- 3790
3790	3810	Lime		DST #2 3796-3810
3810	3820	Lime-Shale		DST #3 3812-3828
3820	3852	Lime		DST #4 3835-3852
3852	3860	Lime-Shale		DST #5 3897-3916
3860	3916	Lime		DST #6 3924-3935
3916	3935	Lime-Shale		Dst #7 3937-3960
3935	3980	Lime		DST #8 3963-3980
3980	4020	Lime-Shale		

RECEIVED
STATE CORPORATION COMMISSION

NOV 26 1962

CONSERVATION DIVISION
Wichita, Kansas

STATE OF KANSAS)
COUNTY OF SEDGWICK) SS.

The undersigned hereby certifies that to the best of his knowledge and belief, the above facts are true and correct.

C-G DRILLING CO.

By G.F. Galloway

THIS 21 day of November, 1962.

Vicky Jacobs
Vicky Jacobs - Notary Public

