

15-065-22803-00-00

For KCC Use: Effective Date: 11-25-2000
District # 4
SGA? Yes No

KANSAS CORPORATION COMMISSION
OIL & GAS CONSERVATION DIVISION

Form C-1
September 1999
Form must be Typed
Form must be Signed
All blanks must be Filled

NOTICE OF INTENT TO DRILL

Must be approved by KCC five (5) days prior to commencing well

Expected Spud Date 11 20 2000
month day year

OPERATOR: License# 32552 ✓
Name: Energy One Oil Operations
Address: 1116 E 8th St
City/State/Zip: Hays, KS 67601
Contact Person: Carl Zimmerman
Phone: (785)623-4488

CONTRACTOR: License# 30076 ✓
Name: A & A PRODUCTION

Well Drilled For: Well Class: Type Equipment:
 Oil Enh Rec Infield Mud Rotary
 Gas Storage Pool Ext. Air Rotary
 OWO Disposal Wildcat Cable
 Seismic; # of Holes Other
 Other

If OWWO: old well information as follows:
Operator: _____
Well Name: _____
Original Completion Date: _____ Original Total Depth: _____

Directional, Deviated or Horizontal wellbore? Yes No
If Yes, true vertical depth: _____
Bottom Hole Location: _____
KCC DKT #: _____

Spot East West
SE - NE - NE Sec. 22 Twp. T10S R. R25W
4290 feet from S / N (circle one) Line of Section
330 feet from E / W (circle one) Line of Section
Is SECTION yes Regular Irregular?

(Note: Locate well on the Section Plat on reverse side)
County: Graham
Lease Name: Knoll C Well #: #1
Field Name: Ambrose
Is this a Prorated / Spaced Field? Yes No
Target Formation(s): LKC
Nearest Lease or unit boundary: 330
Ground Surface Elevation: 2481 feet MSL
Water well within one-quarter mile: Yes No
Public water supply well within one mile: Yes No
Depth to bottom of fresh water: 28' 150'
Depth to bottom of usable water: 1235 ✓
Surface Pipe by Alternate: 1 2 ✓
Length of Surface Pipe Planned to be set: 200 ✓
Length of Conductor Pipe required: none
Projected Total Depth: 4200'
Formation at Total Depth: LKC
Water Source for Drilling Operations:
Well Farm Pond Other
DWR Permit #: _____
(Note: Apply for Permit with DWR)
Will Cores be taken? Yes No
If Yes, proposed zone: _____

AFFIDAVIT

RECEIVED
STATE CORPORATION COMMISSION

The undersigned hereby affirms that the drilling, completion and eventual plugging of this well will comply with K.S.A. 55-101, et. seq.
It is agreed that the following minimum requirements will be met:

1. Notify the appropriate district office prior to spudding of well;
2. A copy of the approved notice of intent to drill shall be posted on each drilling rig;
3. The minimum amount of surface pipe as specified below shall be set by circulating cement to the top; in all cases surface pipe shall be set through all unconsolidated materials plus a minimum of 20 feet into the underlying formation.
4. If the well is dry hole, an agreement between the operator and the district office on plug length and placement is necessary prior to plugging;
5. The appropriate district office will be notified before well is either plugged or production casing is cemented in;
6. If an ALTERNATE II COMPLETION, production pipe shall be cemented from below any usable water to surface within 120 days of spud date. In all cases, NOTIFY district office prior to any cementing.

I hereby certify that the statements made herein are true and to the best of my knowledge and belief.

Date: 11-12-00 Signature of Operator or Agent: Carl Zimmerman Title: Owner

NOV 16 2000
11-16-2000
CONSERVATION DIVISION
Wichita, Kansas

For KCC Use ONLY
API # 15 - 065-22803-0000
Conductor pipe required NONE feet
Minimum surface pipe required 200 feet per Alt. ②
Approved by: JK 11-20-2000
This authorization expires: 5-20-2001
(This authorization void if drilling not started within 6 months of effective date.)
Spud date: _____ Agent: _____

- Remember to:
- File Drill Pit Application (form CDP-1) with Intent to Drill;
 - File Completion Form ACO-1 within 120 days of spud date;
 - File acreage attribution plat according to field proration orders;
 - Notify appropriate district office 48 hours prior to workover or re-entry;
 - Submit plugging report (CP-4) after plugging is completed;
 - Obtain written approval before disposing or injecting salt water.

22
10
25W

IN ALL CASES PLOT THE INTENDED WELL ON THE PLAT BELOW

Plat of acreage attributable to a well in a prorated or spaced field

If the intended well is in a prorated or spaced field, please fully complete this side of the form. If the intended well is in a prorated or spaced field complete the plat below showing that the well will be properly located in relationship to other wells producing from the common source of supply. Please show all the wells and within 1 mile of the boundaries of the proposed acreage attribution unit for gas wells and within 1/2 mile of the boundaries of the proposed acreage attribution unit for oil wells.

API No. 15 - _____
Operator: _____
Lease: _____
Well Number: _____
Field: _____

Location of Well: County: Graham
4290 feet from Ⓢ / N (circle one) Line of Section
330 feet from Ⓟ / W (circle one) Line of Section
Sec. 22 Twp. 10 S. R. 25 East West

Number of Acres attributable to well: _____
QTR / QTR / QTR of acreage: E1/2 - sec22S R25W



Is Section YES Regular or _____ Irregular

If Section is Irregular, locate well from nearest corner boundary.

Section corner used: ___NE ___NW ___SE ___SW

PLAT

(Show location of the well and shade attributable acreage for prorated or spaced wells.)
(Show footage to the nearest lease or unit boundary line.)

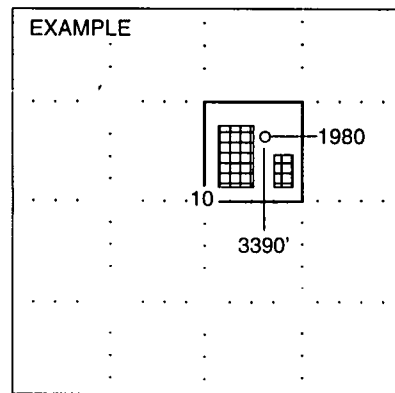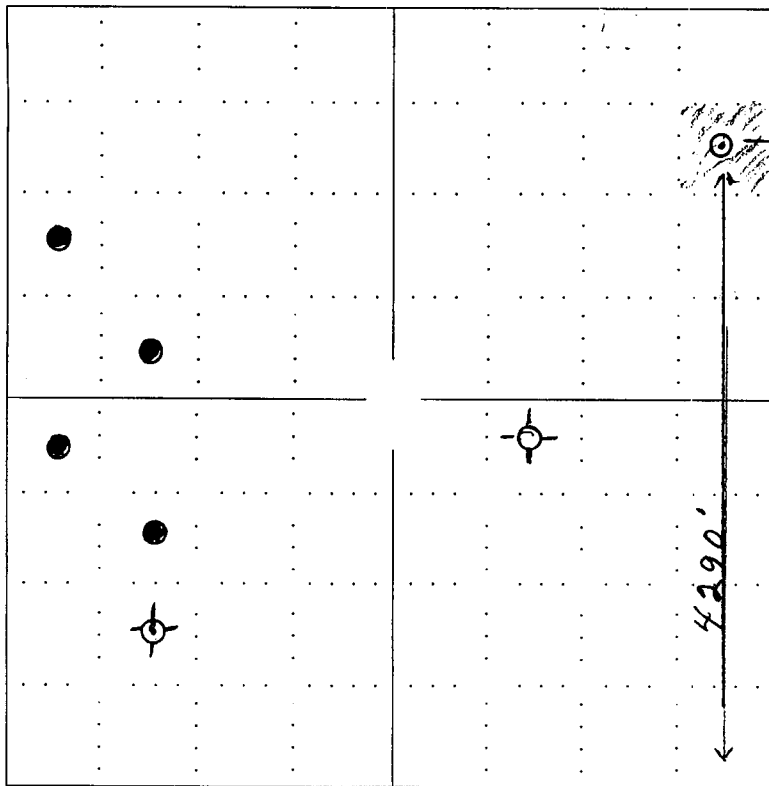

SEWARD CO.

RECEIVED
STATE CORPORATION COMMISSION

NOV 16 2000

In plotting the proposed location of the well, you must show:

1. The manner in which you are using the depicted plat by identifying section lines, i.e. 1 section, 1 section with 8 surrounding sections, 4 sections, etc.
2. The distance of the proposed drilling location from the section's south / north and east / west.
3. The distance to the nearest lease or unit boundary line.
4. If proposed location is located within a prorated or spaced field a certificate of acreage attribution plat must be attached: (CO-7 for oil wells; CG-8 for gas wells).

CONSERVATION DIVISION
Wichita, Kansas