

CARD MUST BE TYPED

State of Kansas  
**NOTICE OF INTENTION TO DRILL**  
(see rules on reverse side)

CARD MUST BE SIGNED

Starting Date: December 18, 1984  
month day year

API Number 15- 065-22,114-0000

OPERATOR: License # 5273

SE NW SW Sec 24 Twp 10 S, Rge 25  East  West  
(location)

Name Kiowa Exploration Company

Address 110 S. Main, Suite #510

City/State/Zip Wichita, Kansas 67202

Contact Person J. Corry Tinsmon

Phone (316) 267-0228

1650 Ft North from Southeast Corner of Section  
4290 Ft West from Southeast Corner of Section  
(Note: Locate well on Section Plat on reverse side)

CONTRACTOR: License # 5107

Nearest lease or unit boundary line 990 feet.

County Graham

Lease Name Knoll Well# 1

Domestic well within 330 feet:  yes  no

Municipal well within one mile:  yes  no

Name H-30 Drilling, Inc.

City/State Wichita, Kansas 67202

Well Drilled For: Well Class: Type Equipment:

- Oil  Swd  Infield  Mud Rotary
- Gas  Inj  Pool Ext.  Air Rotary
- OWWO  Expl  Wildcat  Cable

Depth to Bottom of fresh water 100 feet

Lowest usable water formation 200 *data*

Depth to Bottom of usable water 400 *1175* feet

Surface pipe by Alternate: 1  2

Surface pipe to be set 250 feet

Conductor pipe if any required feet

Ground surface elevation 2504 feet MSL

This Authorization Expires 57325

Approved By 11-13-84 *[Signature]*

If OWWO: old well info as follows:

Operator

Well Name

Comp Date Old Total Depth

Projected Total Depth 3975 feet

Projected Formation at TD Base/Kansas City

Expected Producing Formations Kansas City

I certify that we will comply with K.S.A. 55-101, et seq., plus eventually plugging hole to K.C.C. specifications.

Date 11-13-84 Signature of Operator or Agent *[Signature]*

Title Managing Partner

*MHC/HOME 11/13/84*

Must be filed with the K.C.C. five (5) days prior to commencing well  
This card void if drilling not started within six (6) months of date received by K.C.C.

RECEIVED


MISSION

NOV 13 1984

CONSERVATION DIVISION  
Wichita, Kansas

A Regular Section of Land  
1 Mile = 5,280 Ft.

11-13-84

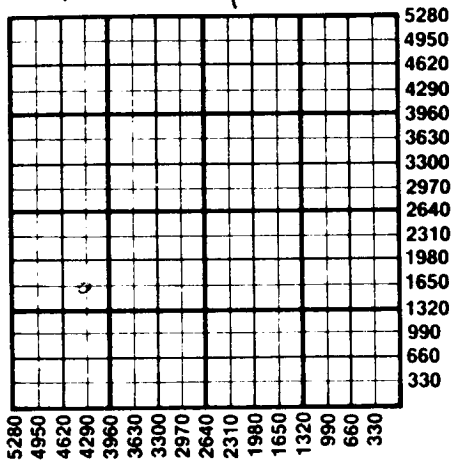

**Important procedures to follow :**

1. Notify District office before setting surface casing.
2. Set surface casing by circulating cement to the top.
3. File completion forms ACO-1 with K.C.C. within 90 days of well completion, following instructions on ACO-1, side 1, and including copies of wireline logs.
4. Notify District office 48 hours prior to old well workover or re-entry.
5. Prior to plugging, prepare a plugging plan, then obtain agreement from the appropriate district office for an approved plugging plan.
6. Submit plugging report (CP-4) to K.C.C. after plugging is completed.
7. Obtain an approved injection docket number before disposing of salt water.
8. Notify K.C.C. within 10 days when injection commences or terminates.
9. If an alternate 2 completion, cement in the production pipe from below any usable water to surface within 120 days of spud date.

State Corporation Commission of Kansas  
Conservation Division  
200 Colorado Derby Building  
Wichita, Kansas 67202  
(316) 263-3238