


WELL PLUGGING RECORD

Give All Information Completely
Make Required Affidavit
Mail or Deliver Report to:
Conservation Division
State Corporation Commission
800 Biting Building
Wichita, Kansas

Graham County. Sec. 11 Twp. 10 Rge. 25 ~~WEX~~ (W)
Location as "NE/CNW/SW" or footage from lines NW NW SW
Lease Owner Empire Drilling Co.
Lease Name Pfeiffer Well No. 1
Office Address 400 Brown Building, Wichita, Kansas
Character of Well (completed as Oil, Gas or Dry Hole) Oil
Date well completed May 14, 19 57
Application for plugging filed May 26, 19 57
Application for plugging approved May 28, 19 57
Plugging commenced May 27, 19 57
Plugging completed June 3, 19 57
Reason for abandonment of well or producing formation Producing water
If a producing well is abandoned, date of last production _____ 19 ____
Was permission obtained from the Conservation Division or its agents before plugging was commenced? Yes

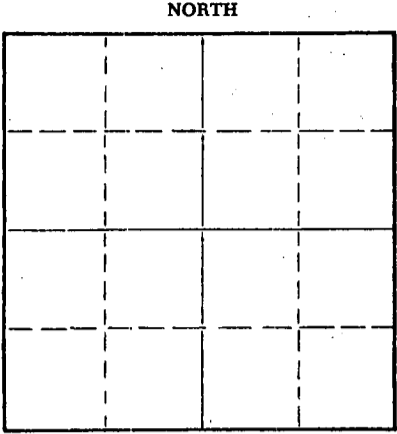

Locate well correctly on above Section Plat

Name of Conservation Agent who supervised plugging of this well Eldon Petty
Producing formation _____ Depth to top _____ Bottom _____ Total Depth of Well 4235 Feet
Show depth and thickness of all water, oil and gas formations.

OIL, GAS OR WATER RECORDS

CASING RECORD

FORMATION	CONTENT	FROM	TO	SIZE	PUT IN	PULLED OUT
		0	221'	8 5/8"	221'	Cemented w/ 140 Sax
			3989'	5 1/2"	3989'	3,283.55'

Describe in detail the manner in which the well was plugged, indicating where the mud fluid was placed and the method or methods used in introducing it into the hole. If cement or other plugs were used, state the character of same and depth placed, from 3245 feet to surface feet for each plug set.

Baker plug had been previously set at 3804', hole filled with sand from 3804' to 3765', 4 sax cement placed in hole with dump bailer, pipe shot off and pulled excepting 850', Halliburton pump trucks thereafter pumped down 15 sax of mud followed by 35 sax cements pumped down through 5 1/2" casing, remainder of pipe pulled and hole mudded to 50', ten foot rock bridge installed between 50 and 40 ft. 15 sax cement poured in hole to fill hole with cement to bottom of cellar.

(If additional description is necessary, use BACK of this sheet)
Name of Plugging Contractor Barnes & Sons Pipe Pulling Co.
Address Russell, Kansas

STATE OF Kansas, COUNTY OF Sedgwick, ss.
I, Dan J. Kornfeld (employee of owner) or (owner or operator) of the above-described well, being first duly sworn on oath, says: That I have knowledge of the facts, statements, and matters herein contained and the log of the above-described well as filed and that the same are true and correct. So help me God.

(Signature) [Signature]
400 Brown Building, Wichita 2, Kansas
(Address)

SUBSCRIBED AND SWORN to before me this 13th day of June, 19 57

My commission expires My Commission Expires Oct. 21, 1958
[Signature] Notary Public.
6-14-1957

PLUGGING
FILE SEC 11 T 10 R 25W
BOOK PAGE 15 LINE 39

COMPANY: EMPIRE DRILLING COMPANY, WICHITA, KANSAS

FARM: F. J. PFEIFER

CONTRACTOR: EMPIRE DRILLING COMPANY, WICHITA, KANSAS

LOCATION: NW NW SW SEC 11-10-25 GRAHAM COUNTY, KANSAS

COMMENCED: APRIL 30, 1957
COMPLETED: MAY 14, 1957

ELEVATION: 2501 KB
POTENTIAL:

0	TO	TO	CLAY AND SAND
70	TO	228	SAND AND SHALE
228	TO	1320	SHALE
1320	TO	1690	SHALE AND SHELLS
1690	TO	2134	SHALE
2134	TO	2170	ANHYDRITE
2170	TO	2435	SHALE AND SHELLS
2435	TO	2540	SHALE AND LIME
2540	TO	2745	SHALE
2745	TO	2965	SHALE AND LIME
2965	TO	3125	SHALE AND SHELLS
3125	TO	3200	SHALE AND LIME
3200	TO	3310	LIME AND SHALE
3310	TO	3460	SHALE AND LIME
3460	TO	3535	SHALE AND SHELLS
3535	TO	3630	LIME AND SHALE
3630	TO	4050	LIME
4050	TO	4140	LIME AND SHALE
4140	TO	4175	LIME
4175	TO	4230	SHALE AND LIME
4230	TO	4235	LIME
		4335	RTD

RAN: 8 5/8" SET 221' WITH 140 SACKS CEMENT
SET: 5 1/2" 3989' WITH 115 SACKS CEMENT

TOPS:	ANHYDRITE	2134
	HEEBNER	3747
	TORONTO	3770
	LANSING KANSAS CITY	3788
	BASE KANSAS CITY	4011
	MARMATON	4106
	CHEROKEE GROUP	4206

I, DAN J. KORNFELD, DO HEREBY CERTIFY THAT THE ABOVE AND FOREGOING IS A TRUE AND CORRECT COPY OF THE LOG ON THE PFEIFER NUMBER 1 NW NW SW SEC. 11-10-25, GRAHAM COUNTY, KANSAS AS REFLECTED BY THE FILES OF THE EMPIRE DRILLING COMPANY.

[Signature]
DAN J. KORNFELD

SUBSCRIBED AND SWORN TO BEFORE ME, A NOTARY PUBLIC WITHIN AND FOR SEDGWICK COUNTY, KANSAS, THIS 22ND DAY OF MAY, 1957

[Signature]
HAZEL PIERSON, NOTARY PUBLIC

MY COMMISSION EXPIRES JULY 2, 1958

PLUGGIN
FILE SEC 11 T 10 25W
BOOK PAGE 15 LINE 39

COMMISSION
5-28-1957
CONSERVATION DIVISION
Wichita, Kansas