


15-065-02069-0000

STATE OF KANSAS  
STATE CORPORATION COMMISSION

Give All Information Completely  
Make Required Affidavit  
Mail or Deliver Report to:  
Conservation Division  
State Corporation Commission  
211 No. Broadway  
Wichita, Kansas

WELL PLUGGING RECORD

NORTH

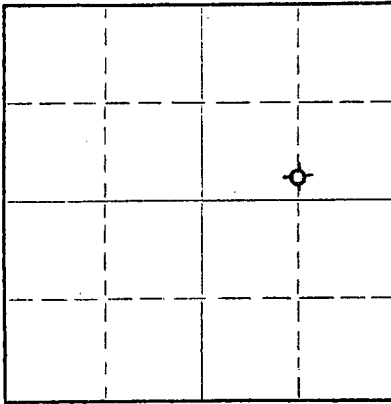

Locate well correctly on above  
Section Plat

Graham County. Sec. 18 Twp. 10 Rge. 25 (E) (W) W  
Location as "NE/CNW $\frac{1}{2}$ SW $\frac{1}{4}$ " or footage from lines C S Line S $\frac{1}{2}$  NE $\frac{1}{4}$   
Lease Owner D. G. Hansen  
Lease Name Hanna Well No. 2  
Office Address Logan, Kansas  
Character of Well (completed as Oil, Gas or Dry Hole) Dry Hole  
Date well completed June 2 1960  
Application for plugging filed June 2 1960  
Application for plugging approved June 2 1960  
Plugging commenced June 2 1960  
Plugging completed June 2 1960  
Reason for abandonment of well or producing formation Too low structurally

If a producing well is abandoned, date of last production \_\_\_\_\_ 19\_\_\_\_  
Was permission obtained from the Conservation Division or its agents before plugging was commenced? Yes

Name of Conservation Agent who supervised plugging of this well Eldon Petty, Hays, Kansas  
Producing formation \_\_\_\_\_ Depth to top \_\_\_\_\_ Bottom \_\_\_\_\_ Total Depth of Well 4050 Feet  
Show depth and thickness of all water, oil and gas formations.

OIL, GAS OR WATER RECORDS

CASING RECORD

FORMATION	CONTENT	FROM	TO	SIZE	PUT IN	PULLED OUT
				8-5/8"	169.81'	None

Describe in detail the manner in which the well was plugged, indicating where the mud fluid was placed and the method or methods used in introducing it into the hole. If cement or other plugs were used, state the character of same and depth placed, from \_\_\_\_\_ feet to \_\_\_\_\_ feet for each plug set.

Filled hole with heavy mud to 400'. Set plug. Put in 20 sacks cement. Filled to 165'. Set plug. Put in 1/2 sack hulls and 20 sacks cement. Filled with heavy mud up to 40'. Set plug. Filled to top with 1/2 sack hulls and 10 sacks cement.


RECEIVED  
STATE CORPORATION COMMISSION  
JUN 15 1960  
CONSERVATION DIVISION  
Wichita, Kansas

Name of Plugging Contractor C-G Drilling Co.  
Address 107 Rule Building, Wichita 2, Kansas

STATE OF KANSAS, COUNTY OF SEDGWICK, ss.  
G. F. Galloway (employee of owner) or (owner or operator) of the above-described well, being first duly sworn on oath, says: That I have knowledge of the facts, statements, and matters herein contained and the log of the above-described well as filed and that the same are true and correct. So help me God.

(Signature) G. F. Galloway  
107 Rule Building  
(Address)

SUBSCRIBED AND SWORN to before me this June 6 day of June 6, 1960

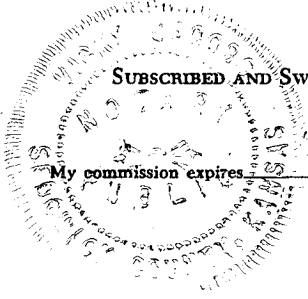

My commission expires May 20, 1963  
Vicky Jacobs  
Notary Public.

15-065-02069-0000

W E L L L O G

OPERATOR D. G. Hansen

SEC. 18-10-25W

WELL NAME Hanna #2

LOC. C S Line S 1/2 NE 1/4

TOTAL DEPTH 4050'

COUNTY Graham

COMM. May 23, 1960

COMP. June 2, 1960

STATE Kansas

RIG NO. 1

ELEVATION 2552' K.B.

CASING: Ran 169.81' (8 jts.) 8-5/8" OD Surface Casing.

PRODUCTION: D & A

All measurements taken from the top of rotary bushing.

FROM	TO	FORMATION	DEVIATION FROM VERTICAL	REMARKS:
0	1405	Sand-Shale		
1405	1675	Shale-Sand		
1675	2130	Red Bed-Shale		
2130	2167	Red Bed		
2167	2207	Anhydrite		
2207	2400	Shale-Shell	0° - 2500	
2400	2950	Shale-Lime	0° - 2750	
2950	3055	Lime-Shale	0° - 3000	
3055	3265	Shale-Lime	0° - 3250	
3265	3695	Lime-Shale	0° - 3500	
3695	3735	Lime		
3735	3804	Shale-Lime	0° - 3750	DST 3776-3804'
3804	3815	Lime-Shale		DST 3826-3843'
3815	4050	Lime		DST 3926-3950'
				DST 3960-4015'

RECEIVED  
 STATE CORPORATION COMMISSION  
 JUN 15 1960  
 CONSERVATION DIVISION  
 Wichita, Kansas

STATE OF KANSAS }  
 COUNTY OF SEDGWICK } SS.

The undersigned hereby certifies that to the best of his knowledge and belief, the above facts are true and correct.

C-G DRILLING CO.  
 By G. F. Galloway

SUBSCRIBED AND SWORN TO, BEFORE ME, THIS 6th day of June, 1960.

My commission expires:  
 May 20, 1963

Vicky Jacobs  
 Vicky Jacobs - Notary public

