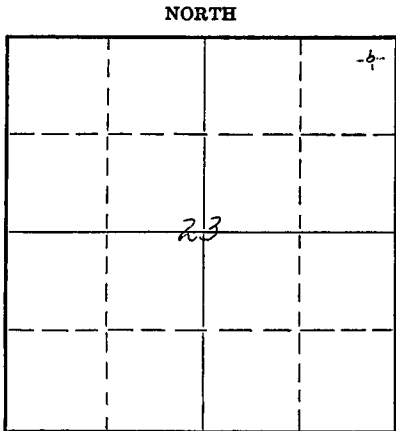


WELL PLUGGING RECORD

Give All Information Completely  
Make Required Affidavit  
Mail or Deliver Report to:  
Conservation Division  
State Corporation Commission  
800 Bittling Building  
Wichita, Kansas

Graham County. Sec. 23 Twp. 10S Rge. (E) 25 (W)

Location as "NE/CNW $\frac{1}{4}$ SW $\frac{1}{4}$ " or footage from lines NE NE NE  
Lease Owner Herndon Drilling Company  
Lease Name Schreiner Well No. 4  
Office Address P. O. Box 489, Tulsa, Oklahoma  
Character of Well (completed as Oil, Gas or Dry Hole) Dry Hole  
Date well completed October 9 1964  
Application for plugging filed 19  
Application for plugging approved October 9 1964  
Plugging commenced October 9 1964  
Plugging completed October 9 1964  
Reason for abandonment of well or producing formation



Locate well correctly on above Section Plat

If a producing well is abandoned, date of last production 19  
Was permission obtained from the Conservation Division or its agents before plugging was commenced? Yes

Name of Conservation Agent who supervised plugging of this well W. L. Nichols, Moreland, Kansas  
Producing formation None Depth to top Bottom Total Depth of Well 3985 Feet  
Show depth and thickness of all water, oil and gas formations.

OIL, GAS OR WATER RECORDS

CASING RECORD

Formation	Content	From	To	Size	Put In	Pulled Out
				10-3/4"	206'	none

Describe in detail the manner in which the well was plugged, indicating where the mud fluid was placed and the method or methods used in introducing it into the hole. If cement or other plugs were used, state the character of same and depth placed, from feet to feet for each plug set.

Hole full of mud. Cement plugs placed from 540' to 414', from 190'-139', and from 25' to top of surface casing. Used 65 sacks of common cement.

RECEIVED  
STATE CORPORATION COMMISSION

DEC 1 1964

12-01-64  
CONSERVATION DIVISION  
Wichita, Kansas

(If additional description is necessary, use BACK of this sheet)

Correspondence regarding this well should be addressed to Herndon Drilling Company  
Address P. O. Box 489, Tulsa, Oklahoma

STATE OF OKLAHOMA, COUNTY OF TULSA, ss.  
James H. Duck, Jr. (employee of owner) or (owner or operator) of the above-described well,

being first duly sworn on oath, says: That I have knowledge of the facts, statements, and matters herein contained and the log of the above-described well as filed and that the same are true and correct. So help me God.

(Signature) James H. Duck, Jr.  
P. O. Box 489, Tulsa, Oklahoma  
(Address)

SUBSCRIBED AND SWORN TO before me this 24th day of November, 1964

Helen H. Burden  
Notary Public.

My commission expires May 18, 1968

15-065-19227-0000

GABBERT-JONES INC.  
WICHITA, KANSAS  
DRILLERS WELL LOG

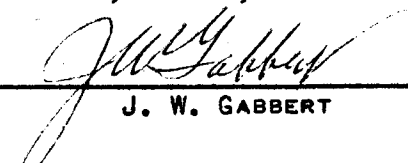
SCHREINER #4  
NE NE NE SECTION 23-10S-25W  
GRAHAM COUNTY, KANSAS

COMMENCED: OCTOBER 1, 1964  
COMPLETED: OCTOBER 9, 1964

OPERATOR - HERNDON DRILLING COMPANY

<u>DEPTH</u>		<u>FORMATION</u>	<u>REMARKS</u>
FROM	TO		
0	206	SOIL & SHALE	RAN 210' OF 10-3/4" CASING SET @ 206' W/ 175 SACKS CEMENT
206	340	SHALE	
340	1303	SHALE & SAND	
1303	1550	SHALE	
1550	2090	RED BED & SHALE	
2090	2120	ANHYDRITE	
2120	2186	RED BED & SHALE	
2186	3856	LIME & SHALE	
3856	3985	LIME	
3985	TO		DRY & ABANDONED

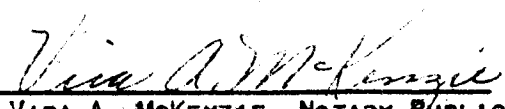
I, J. W. GABBERT, CERTIFY THIS IS A CORRECT COPY OF THE DRILLER'S WELL LOG FOR THE WELL DRILLED IN NE NE NE SECTION 23-10S-25W, GRAHAM COUNTY, KANSAS, TO THE BEST OF MY KNOWLEDGE AND BELIEF.

  
\_\_\_\_\_  
J. W. GABBERT

STATE OF KANSAS )  
                          ) SS  
COUNTY OF SEDGWICK )

BEFORE ME, THE UNDERSIGNED, A NOTARY PUBLIC WITHIN AND FOR SAID COUNTY AND STATE ON THIS 12TH DAY OF OCTOBER, 1964, PERSONALLY APPEARED J. W. GABBERT TO ME PERSONALLY KNOWN TO BE THE IDENTICAL PERSON WHO EXECUTED THE WITHIN AND FOREGOING INSTRUMENT AND ACKNOWLEDGED TO ME THAT HE EXECUTED THE SAME AS HIS FREE AND VOLUNTARY ACT AND DEED FOR THE USES AND PURPOSES THEREIN SET FORTH.

IN WITNESS WHEREOF, I HAVE HEREUNTO SET MY HAND AND OFFICIAL SEAL THE DAY AND YEAR LAST ABOVE WRITTEN.

  
\_\_\_\_\_  
VIRA A. MCKENZIE, NOTARY PUBLIC

MY COMMISSION EXPIRES OCTOBER 2, 1967

DEC 1 1964  
CONSERVATION DIVISION  
WICHITA, KANSAS