

15-065-20009-00-01

SIDE ONE

065-20,009-00-01

STATE CORPORATION COMMISSION OF KANSAS
OIL & GAS CONSERVATION DIVISION
WELL COMPLETION FORM
ACO-1 WELL HISTORY
DESCRIPTION OF WELL AND LEASE

API NO. 15- NONE AVAILABLE

County GRAHAM

NE NE NW Sec. 20 Twp. 10S Rge. 24W East West

4950 Ft. North from Southeast Corner of Section

2970 Ft. West from Southeast Corner of Section
(NOTE: Locate well in section plat below.)

Lease Name G. RUSH "B" Well # 2

Field Name HIGH HILL

Producing Formation LANSING-KANSAS CITY

Elevation: Ground 2445 KB 2450

Total Depth 4009 PBDT 3990

Operator: License # 03135

Name: CRUMP PETROLEUM CORP.

Address P.O. BOX 50820

MIDLAND, TEXAS 79701

City/State/Zip

Purchaser: N/A

Operator Contact Person: LEA CRUMP

Phone 015) 687-2008

Contractor: Name: L.J. DREILING & SON

License: Unknown

Wellsite Geologist: STANFORD S. COX

Designate Type of Completion
 New Well Re-Entry Workover

Oil SWD Temp. Abd.
 Gas Inj Delayed Comp.
 Dry Other (Core, Water Supply, etc.)

If **OWMO**: old well info as follows:
Operator: DON E. PRATT, Original Oper.


Well Name: G. RUSH "B" #2

Comp. Date 10/24/67 Old Total Depth 4009

Drilling Method:
 Mud Rotary Air Rotary Cable

2/8/67 2/14/67 2/27/67

Spud Date Date Reached TD Completion Date

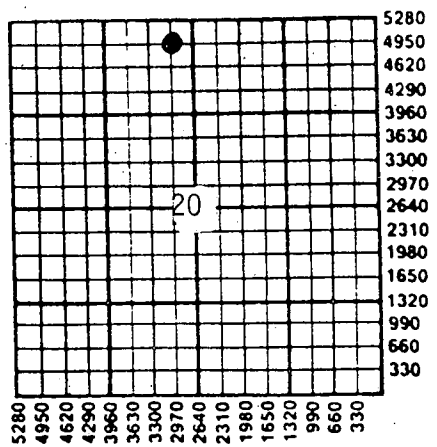

Amount of Surface Pipe Set and Cemented at 175' Feet

Multiple Stage Cementing Collar Used? ?? Yes No

If yes, show depth set _____ Feet

If Alternate II completion, cement circulated from _____

feet depth to _____ w/ _____ sx cmt.

MAR 15 1990
3-15-1990

INSTRUCTIONS: This form shall be completed in triplicate and filed with the Kansas Corporation Commission, 200 Colorado Derby Building, Wichita, Kansas 67202, within 120 days of the spud date of any well. Rule 82-3-130, 82-3-107 and 82-3-106 apply. Information on side two of this form will be held confidential for a period of 12 months if requested in writing and submitted with the form. See rule 82-3-107 for confidentiality in excess of 12 months. One copy of all wireline logs and drillers time log shall be attached with this form. ALL CEMENTING TICKETS MUST BE ATTACHED. Submit CP-4 form with all plugged wells. Submit CP-111 form with all temporarily abandoned wells. Any recompletion, workover or conversion of a well requires filing of ACO-2 within 120 days from commencement date of such work.

All requirements of the statutes, rules and regulations promulgated to regulate the oil and gas industry have been fully complied with and the statements herein are complete and correct to the best of my knowledge.

Signature Robert D. Preece

Title Agent Date 3/9/90

Subscribed and sworn to before me this 9th day of March 1990.

Notary Public Mary E. Leyva

Date Commission Expires 2-8-92

K.C.C. OFFICE USE ONLY
F Letter of Confidentiality Attached
C Wireline Log Received
C Drillers Timelog Received

Distribution
 KCC SWD/Rep NGPA
 KGS Plug Other
(Specify)

ORIGINAL

SIDE TWO

Operator Name CRUMP PETROLEUM CORP. Lease Name G. RUSH "B" Well # 2
 Sec. 20 Twp. 10S Rge. 24W East County GRAHAM
 West

INSTRUCTIONS: Show important tops and base of formations penetrated. Detail all cores. Report all drill stem tests giving interval tested, time tool open and closed, flowing and shut-in pressures, whether shut-in pressure reached static level, hydrostatic pressures, bottom hole temperature, fluid recovery, and flow rates if gas to surface during test. Attach extra sheet if more space is needed. Attach copy of log.

Drill Stem Tests Taken <input checked="" type="checkbox"/> Yes <input type="checkbox"/> No (Attach Additional Sheets.) Samples Sent to Geological Survey <input checked="" type="checkbox"/> Yes <input type="checkbox"/> No Cores Taken <input checked="" type="checkbox"/> Yes <input type="checkbox"/> No Electric Log Run <input checked="" type="checkbox"/> Yes <input type="checkbox"/> No (Submit Copy.) LOG SUBMITTED WITH CP-1 (1-25-90)	<table border="1" style="width:100%; border-collapse: collapse;"> <thead> <tr> <th colspan="3" style="text-align: center;">Formation Description</th> </tr> <tr> <th style="width:50%;"></th> <th style="width:25%; text-align: center;"><input checked="" type="checkbox"/> Log</th> <th style="width:25%; text-align: center;"><input type="checkbox"/> Sample</th> </tr> <tr> <th style="text-align: left;">Name</th> <th style="text-align: center;">Top</th> <th style="text-align: center;">Bottom</th> </tr> </thead> <tbody> <tr> <td>ANHYDRITE</td> <td style="text-align: center;">2074</td> <td style="text-align: center;">2108</td> </tr> <tr> <td>HEEBNER</td> <td style="text-align: center;">3720</td> <td style="text-align: center;">3746</td> </tr> <tr> <td>TORONTO</td> <td style="text-align: center;">3746</td> <td style="text-align: center;">3760</td> </tr> <tr> <td>LANSING-KC</td> <td style="text-align: center;">3760</td> <td style="text-align: center;">4009</td> </tr> </tbody> </table>	Formation Description				<input checked="" type="checkbox"/> Log	<input type="checkbox"/> Sample	Name	Top	Bottom	ANHYDRITE	2074	2108	HEEBNER	3720	3746	TORONTO	3746	3760	LANSING-KC	3760	4009
Formation Description																						
	<input checked="" type="checkbox"/> Log	<input type="checkbox"/> Sample																				
Name	Top	Bottom																				
ANHYDRITE	2074	2108																				
HEEBNER	3720	3746																				
TORONTO	3746	3760																				
LANSING-KC	3760	4009																				

CASING RECORD <input type="checkbox"/> New <input type="checkbox"/> Used							
Report all strings set-conductor, surface, intermediate, production, etc.							
Purpose of String	Size Hole Drilled	Size Casing Set (In O.D.)	Weight Lbs./Ft.	Setting Depth	Type of Cement	# Sacks Used	Type and Percent Additives
SURFACE	12-1/4"	8-5/8"	23#	175	???	150	???
PRODUCTION	7-7/8"	4-1/2"	9.5#	4009	???	????	???

Shots Per Foot	PERFORATION RECORD Specify Footage of Each Interval Perforated	Acid, Fracture, Shot, Cement Squeeze Record (Amount and Kind of Material Used) Depth
	3792-96	
	3840-44	
	3914-24	
	3936-42	
	3955-60	

TUBING RECORD	Size	Set At	Packer At	Liner Run <input type="checkbox"/> Yes <input type="checkbox"/> No
---------------	------	--------	-----------	--

Date of First Production UNKNOWN	Producing Method <input type="checkbox"/> Flowing <input checked="" type="checkbox"/> Pumping <input type="checkbox"/> Gas Lift <input type="checkbox"/> Other (Explain)
-------------------------------------	--

Estimated Production Per 24 Hours	Oil Bbls.	Gas Mcf	Water Bbls.	Gas-Oil Ratio	Gravity
	UNKNOWN	NIL	UNKNOWN		


Disposition of Gas: Vented Sold Used on Lease (If vented, submit ACO-18.)

METHOD OF COMPLETION


Open Hole Perforation Dually Completed Commingled

Other (Specify) _____

Production Interval _____

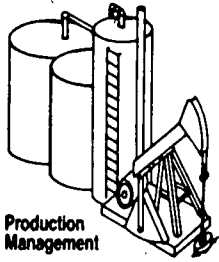

ROBERT D. BOCELL
Petroleum Consultant
2115 MELISSA ST.
ARLINGTON, TEXAS 76010
(817) 460-6539

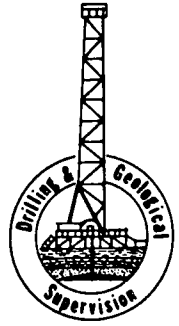

March 9, 1990

KANSAS CORPORATION COMMISSION
200 Colorado Derby Building
Wichita, Kansas 67202

ADDENDUM - WELL HISTORY Form ACO-1

OPERATOR:	CRUMP PETROLEUM CORP.	LEASE:	G. RUSH "B"
LOCATION:	NE NE NW 20-10S-24W	WELL NO.	2
COUNTY:	GRAHAM	FIELD:	HIGH HILL

The subject well has been operated by a multitude of independent operators in the past and consequently the well records are incomplete.

Only data, with reasonable certainty, has been submitted on the attached Form ACO-1 (Well History).

Robert Bocell
Robert Bocell, Agent
CRUMP PETROLEUM CORP.

RECEIVED
MAR 15 1990
3-15-1990