

RECEIVED
STATE CORPORATION COMMISSION
Resd 1-7-82
(REV) ACO-1

SIDE ONE

AFFIDAVIT OF COMPLETION FORM

This form shall be filed in duplicate with the Kansas Corporation Commission, 200 Colorado Derby Building, Wichita, Kansas 67202, within ten days after the completion of the well, regardless of how the well was completed.

Attach separate letter of request if the information is to be held confidential. If confidential, only file one copy. Information on side one will be of public record and side two will then be held confidential.

Circle one: Oil, Gas, Dry, SWD, OWWO, Injection. Type and complete ALL sections. Applications must be filed for dual completion, commingling, SWD and injection.

Attach wireline logs (i.e. electrical log, sonic log, gamma ray neutron log, etc.). KCC # (316) 263-3238. (Rules 82-2-105 & 82-2-125)

OPERATOR Saco Oil Company

API NO. 15-015-21,933-00-00

ADDRESS Box 231 - 115 W. Fifth
El Dorado, KS 67042

COUNTY Butler

FIELD REYNOLDS SWAFFER

**CONTACT PERSON Carol J. Kutz
PHONE 316-321-3515

PROD. FORMATION _____

PURCHASER _____

LEASE McGinnis

ADDRESS _____

WELL NO. 16

WELL LOCATION _____

DRILLING McAllister Drilling Co., Inc.
CONTRACTOR
ADDRESS 251 N. Water, Suite 10
Wichita, KS 67202


990 Ft. from West Line and

990 Ft. from South Line of

the SEC. 9 TWP. 27S RGE. 6W - E?

PLUGGING United Cementing & Acid, Co., Inc.
CONTRACTOR
ADDRESS 2012 W. 6th, Box 712
El Dorado, KS 67042

WELL PLAT

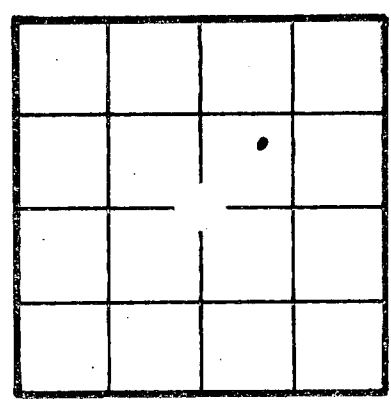

KCC
KGS
(Office Use)

TOTAL DEPTH 2800' PBTD _____

SPUD DATE 12/1/81 DATE COMPLETED 12/5/81

ELEV: GR _____ DF _____ KB _____

DRILLED WITH ~~(CABLE)~~ (ROTARY) ~~(AIR)~~ TOOLS

Amount of surface pipe set and cemented 209' DV Tool Used? _____

A F F I D A V I T

STATE OF Kansas, COUNTY OF Butler SS, I, _____

Clifford W. Stone OF LAWFUL AGE, BEING FIRST DULY SWORN UPON HIS OATH,

DEPOSES THAT HE IS Secretary-Treasurer (FOR)(OF) Saco Oil Company

OPERATOR OF THE McGinnis LEASE, AND IS DULY AUTHORIZED TO MAKE

THIS AFFIDAVIT FOR AND ON THE BEHALF OF SAID OPERATOR, THAT WELL NO. 16 ON

SAID LEASE HAS BEEN COMPLETED AS OF THE 5 DAY OF December, 19 81, AND THAT

ALL INFORMATION ENTERED HEREIN WITH RESPECT TO SAID WELL IS TRUE AND CORRECT.

FURTHER AFFIANT SAITH NOT.

SACO OIL COMPANY

X (S) Clifford W. Stone, Sec-Tr
Clifford W. Stone, Sec-Tr
SUBSCRIBED AND SWORN BEFORE ME THIS 5th DAY OF January, 19 82

OFFICIAL SEAL - STATE NOTARY PUBLIC
ALBERTA M. WELKER, BUTLER COUNTY, KANSAS
MY COMMISSION EXPIRES: 2-12-83

Alberta M. Welker
NOTARY PUBLIC

**The person who can be reached by phone regarding any questions concerning this information. Within 45 days of completion, a witnessed initial test by the Commission is required if the well produces more than 25 BOPD or is located in a Basic Order Pool.

SIDE TWO

WELL LOG

SHOW GEOLOGICAL MARKERS, LOGS RUN, OR OTHER DESCRIPTIVE INFORMATION.

Show all important zones of porosity and contents thereof; cored intervals, and all drill-stem tests, including depth interval tested, cushion used, time tool open, flowing and shut-in pressures, and recoveries.

FORMATION DESCRIPTION, CONTENTS, ETC.	TOP	BOTTOM	NAME	DEPTH
Lime Rotary Total Depth				2800' 2800'

Report of all strings set — surface, intermediate, production, etc. **CASING RECORD** (New) or (Used)

Purpose of string	Size hole drilled	Size casing set (in O.D.)	Weight lbs/ft.	Setting depth	Type cement	Sacks	Type and percent additives
Surface		8-5/8	24#	209'	Common	70	2% cc, 3% gel

LINER RECORD

PERFORATION RECORD

Top, ft.	Bottom, ft.	Sacks cement	Shots per ft.	Size & type	Depth interval

TUBING RECORD		
Size	Setting depth	Packer set at

ACID, FRACTURE, SHOT, CEMENT SQUEEZE RECORD

Amount and kind of material used	Depth interval treated

Date of first production	Producing method (flowing, pumping, gas lift, etc.)	Gravity
--------------------------	---	---------

RATE OF PRODUCTION PER 24 HOURS	Oil bbls.	Gas MCF	Water %	Gas-oil ratio bbls.	CFPB
--	-----------	---------	---------	---------------------	------

Disposition of gas (vented, used on lease or sold)	Perforations
--	--------------