

NOTICE OF INTENTION TO DRILL

(see rules on reverse side)

Starting Date March 17, 1987
month day year 3:55

API Number 15— 065-22, 363-0000

OPERATOR: License # 5462
Name L. G. Stephenson & Co., Inc.
Address 1524 North 143rd Street E.
City/State/Zip Wichita, KS 67230
Contact Person John Japp
Phone 1-316-733-2465

E/2 NE SE Sec. 23 Twp. 10 S, Rg 25 X East
1980 Ft. from South Line of Section
330 Ft. from East Line of Section

(Note: Locate well on Section Plat on reverse side)

CONTRACTOR: License # 5864
Name Lobo Drilling Co.
City/State

Nearest lease or unit boundary line 330 feet
County Graham
Lease Name Kinderknecht Well # 1

Ground surface elevation 2471 feet MSL

Well Drilled For: Well Class: Type Equipment:
 Oil SWD Infield Mud Rotary
 Gas Inj Pool Ext. Air Rotary
 OWWO Expl Wildcat Cable

Domestic well within 330 feet: yes no
Municipal well within one mile: yes no

Depth to bottom of fresh water 120

Depth to bottom of usable water 1125'

Surface pipe by Alternate: 1 2

If OWWO: old well info as follows:

Surface pipe planned to be set 200'

Conductor pipe required none

Projected Total Depth 4050 feet

Formation LKC

I certify that well will comply with K.S.A. 55-101, et seq., plus eventually plugging hole to KCC specifications.

Date 3/16/87 Signature of Operator or Agent Title: Geologist

For KCC Use:

Conductor Pipe Required 9-16-87 feet; Minimum Surface Pipe Required 200 feet per Alt. 2


This Authorization Expires 3-16-87 Approved By 2

Must be filed with the K.C.C. five (5) days prior to commencing well
This card void if drilling not started within six (6) months of date received by K.C.C.

Important procedures to follow:

1. Notify District office before setting surface casing.
2. Set surface casing by circulating cement to the top.
3. File completion forms ACO-1 with K.C.C. within 90 days of well completion, following instructions on ACO-1, side 1, and including copies of wireline logs.
4. Notify District office 48 hours prior to old well workover or re-entry.
5. Prior to filing Intent, prepare a proposed plugging plan in case well is D & A, then obtain approval of plan when calling district office prior to setting surface pipe.
6. Submit plugging report (CP-4) to K.C.C. after plugging is completed.
7. Obtain an approved injection docket number before disposing of salt water.
8. Notify K.C.C. within 10 days when injection commences or terminates.

**A Regular Section of Land
1 Mile = 5,280 Ft.**

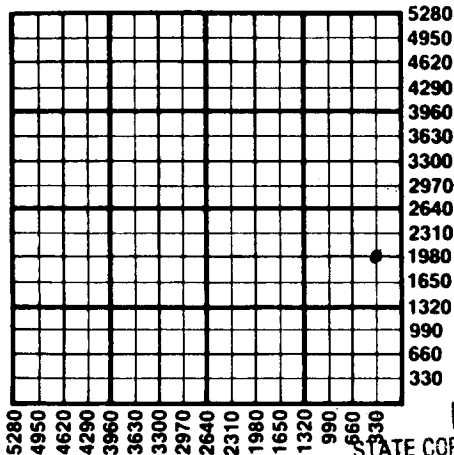

RECEIVED

STATE CORPORATION COMMISSION

3-16-87
MAR 16 1987

CONSERVATION DIVISION
Wichita, Kansas

alternate 2 completion, cement in the production pipe from below any usable water to surface within 120 days of spud date.

State Corporation Commission of Kansas
Conservation Division
200 Colorado Derby Building
Wichita, Kansas 67202
(316) 263-3238