

**KANSAS CORPORATION COMMISSION
OIL & GAS CONSERVATION DIVISION
APPLICATION FOR SURFACE PIT**

Form CDP-1
April 2004
Form must be Typed

Submit in Duplicate

Operator Name: Kansas Natural Gas Operating, Inc.		License Number: 32787
Operator Address: P. O. Box 815 Sublette, KS 67877		
Contact Person: Steve Lehning		Phone Number: (620) 675 - 8185
Lease Name & Well No.: Finnup 1-3		Pit Location (QQQQ): NW - NW - NW - 1/4 Sec. 20 Twp. 24 R. 34 <input type="checkbox"/> East <input checked="" type="checkbox"/> West 150' Feet from <input checked="" type="checkbox"/> North / <input type="checkbox"/> South Line of Section 150' Feet from <input type="checkbox"/> East / <input checked="" type="checkbox"/> West Line of Section Finney County
Type of Pit: <input type="checkbox"/> Emergency Pit <input type="checkbox"/> Burn Pit <input type="checkbox"/> Settling Pit <input type="checkbox"/> Drilling Pit <input type="checkbox"/> Workover Pit <input checked="" type="checkbox"/> Haul-Off Pit <small>(If WP Supply API No. or Year Drilled)</small> (Off Site Reserve Pit)	Pit is: <input checked="" type="checkbox"/> Proposed <input type="checkbox"/> Existing If Existing, date constructed: _____ Pit capacity: 2400 (bbls)	
Is the pit located in a Sensitive Ground Water Area? <input type="checkbox"/> Yes <input checked="" type="checkbox"/> No		Chloride concentration: N/A mg/l <small>(For Emergency Pits and Settling Pits only)</small>
Is the bottom below ground level? <input checked="" type="checkbox"/> Yes <input type="checkbox"/> No	Artificial Liner? <input type="checkbox"/> Yes <input checked="" type="checkbox"/> No	How is the pit lined if a plastic liner is not used? Gel-Mud
Pit dimensions (all but working pits): 70' Length (feet) 70' Width (feet) N/A: Steel Pits Depth from ground level to deepest point: 4' (feet)		
If the pit is lined give a brief description of the liner material, thickness and installation procedure. N/A		Describe procedures for periodic maintenance and determining liner integrity, including any special monitoring. N/A
Distance to nearest water well within one-mile of pit 1380 feet Depth of water well 550 feet		Depth to shallowest fresh water 450 feet. Source of information: _____ measured <input checked="" type="checkbox"/> well owner _____ electric log _____ KDWR
Emergency, Settling and Burn Pits ONLY: Producing Formation: _____ Number of producing wells on lease: _____ Barrels of fluid produced daily: _____ Does the slope from the tank battery allow all spilled fluids to flow into the pit? <input type="checkbox"/> Yes <input type="checkbox"/> No		Drilling, Workover and Haul-Off Pits ONLY: Type of material utilized in drilling/workover: Fresh Water - Drill Mud Number of working pits to be utilized: One Abandonment procedure: Evaporate Till Dry - Backfill and Spread Manure Over Location. Drill pits must be closed within 365 days of spud date.
<p align="right">RECEIVED KANSAS CORPORATION COMMISSION</p>		
I hereby certify that the above statements are true and correct to the best of my knowledge and belief.		
<u>10/11/07</u> Date	<u>Steven M. Lehning, Supt.</u> Signature of Applicant or Agent	OCT 15 2007 CONSERVATION DIVISION WICHITA, KS

15-055-21953 H

KCC OFFICE USE ONLY		
Date Received: <u>10/15/07</u>	Permit Number: <u>15-055-21953-0000</u>	Permit Date: <u>10/19/07</u> Lease Inspection: <input type="checkbox"/> Yes <input checked="" type="checkbox"/> No

Mail to: KCC - Conservation Division, 130 S. Market - Room 2078, Wichita, Kansas 67202

District #1

Kansas Corporation Commission Reserve Pit Inspection Report

Dodge City

Operator Kansas Natural Gas Contractor Trinidad

Well Name Finney 1-3 Haul off pit County Finney

Location NW NW NW Sec. 20 Twp. 24 Rge. 3A W

Footage 150 FROM N S Line
150 FROM E W Line


Spud Date _____ Gave to Kerby
Date Called Out 10/19/07 on 10/19/07
Date Checked 10/19/07

Distance to nearest water well? 1000
Depth to Water? 30?


Recommendations
 Normal Procedure
 Remove Free Fluid
 Line Pit and Remove Free Fluid
 Use Steel Pits

Comments
The offsite reserve pit is in the corner of a pivot irrigated circle circles 0.2 1/2 miles S of Arkansas River. No water bodies in the area.

Report By: Ken Kwik

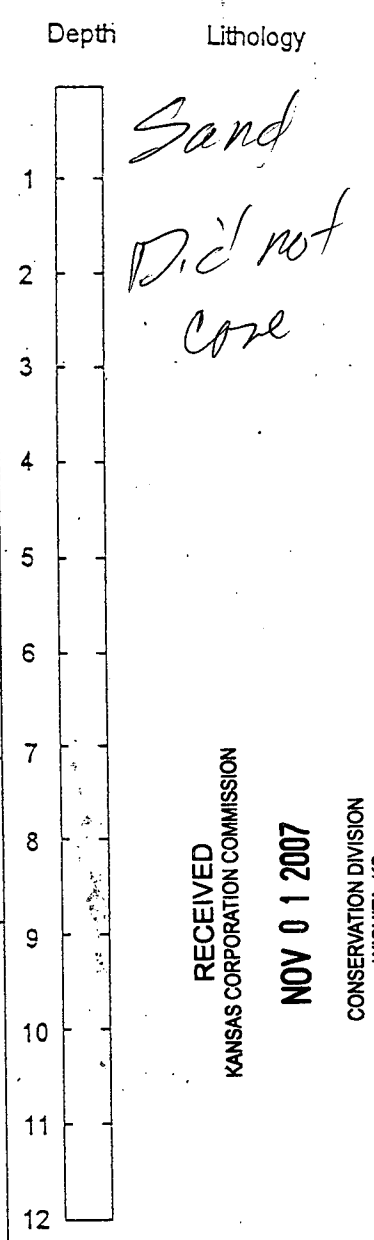

RECEIVED
KANSAS CORPORATION COMMISSION
NOV 01 2007
CONSERVATION DIVISION
WICHITA, KS

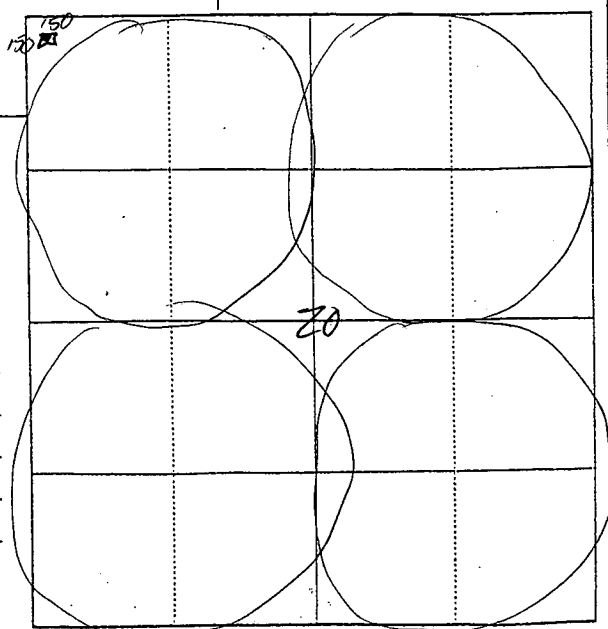

[Handwritten mark]