


15-179-000-77-0000

WELL PLUGGING RECORD

Give All Information Completely
Make Required Affidavit
Mail or Deliver Report to:
Conservation Division
State Corporation Commission
211 No. Broadway
Wichita, Kansas

Sheridan County. Sec. 3 Twp. 10S Rge. 26W (X) (W)
Location as "NE/CNW/SW" or footage from lines NE 1/4 NE 1/4 SW 1/4
Lease Owner Leben Drilling, Inc.
Lease Name Deines Well No. 1
Office Address 905 Central Bldg., Wichita, Kansas
Character of Well (completed as Oil, Gas or Dry Hole) Dry Hole
Date well completed 2-6-58 19__
Application for plugging filed 2-6-58 19__
Application for plugging approved 2-6-58 19__
Plugging commenced 2-6-58 19__
Plugging completed 2-6-58 19__
Reason for abandonment of well or producing formation Dry Hole

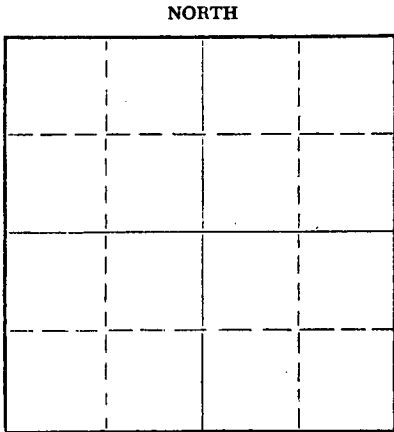

Locate well correctly on above Section Plat

If a producing well is abandoned, date of last production - 19__
Was permission obtained from the Conservation Division or its agents before plugging was commenced? Yes.

Name of Conservation Agent who supervised plugging of this well A. D. Fabricius
Producing formation _____ Depth to top _____ Bottom _____ Total Depth of Well _____ Feet
Show depth and thickness of all water, oil and gas formations.

OIL, GAS OR WATER RECORDS

CASING RECORD

FORMATION	CONTENT	FROM	TO	SIZE	PUT IN	PULLED OUT
				8 5/8"	236'	

Describe in detail the manner in which the well was plugged, indicating where the mud fluid was placed and the method or methods used in introducing it into the hole. If cement or other plugs were used, state the character of same and depth placed, from _____ feet to _____ feet for each plug set.

1st plug @ 500' w/25 sacks cement
2nd plug @ 250' w/15 sacks cement
top plug @ 40' w/10 sacks cement to base of cell
ar

2-11-58

(If additional description is necessary, use BACK of this sheet)

Name of Plugging Contractor Leben Drilling, Inc.
Address 905 Central Bldg., Wichita, Kansas

STATE OF Kansas, COUNTY OF Sedgwick, ss.
L. Frank Hamlin (employee of owner) or (owner or operator) of the above-described well, being first duly sworn on oath, says: That I have knowledge of the facts, statements, and matters herein contained and the log of the above-described well as filed and that the same are true and correct. So help me God.

(Signature) Frank Hamlin
905 Central Bldg. Wichita, Kansas
(Address)

SUBSCRIBED AND SWORN TO before me this 10th day of February, 19 58

Ruth N. Benjamin
Ruth N. Benjamin Notary Public.

My commission expires June 17, 1961

PLUGGING
NO. SEC 3 T.10 R26W
BOOK PAGE 81 LINE 32

DRILLER'S LOG

COMPANY:
CONTRACTOR:
FARM:
LOCATION:

LEBEN DRILLING, INC.
LEBEN DRILLING, INC.
DEINES #1
NE 1/4 NE 1/4 SW 1/4 SEC. 3-105-26W
SHERIDAN COUNTY, KANSAS
JANUARY 26, 1958
FEBRUARY 6, 1958

COMMENCED:
COMPLETED:

0	15	Sand		
15	136	Surface Sand & Shale		
136	236	Blue Shale		
236	800	Shale & Shells		
800	1440	Shale & Sand		
1440	1590	Shale & Sand	TOPS:	
1590	1820	Lime & Shale	Anhydrite	2220
1820	1990	Sand	Topeka	3590
1990	2095	Shale	Heebner	3812
2095	2220	Shale & Redwood	Toronto	3832
2220	2255	Anhydrite	Lansing	3850
2255	2525	Shale & Shells	Bs. K.C.	4083
2525	3175	Shale & Lime		
3175	3615	Lime & Shale	Elevation	2590 K.B.
3615	3812	Lime & Shale		
3812	3815	Heebner		
3815	3860	Lime & Shale		
3860	3990	Lime		
3990	4093	Lime		
4093	4103	Shale		
	4103	<u>Rotary Total Depth - D & A</u>		

Set 236' of 8 5/8" surface casing with 160 sacks cement & 3% CaCl.

I, Frank Hamlin, do hereby certify that the above and foregoing is a true and correct copy of the log of the Deines #1, located NE 1/4 NE 1/4 SW 1/4 of Section 3, Township 10 South, Range 10 West, Sheridan County, Kansas, as reflected by the files of Leben Drilling, Inc.

LEBEN DRILLING, INC.

By: Frank Hamlin
Frank Hamlin

STATE OF KANSAS)
COUNTY OF SEDGWICK) SS:

Subscribed and sworn to before me, a Notary Public, in and for Sedgwick County, Kansas, this 10th day of February, 1958.

Ruth H. Benjamin
Ruth H. Benjamin, Notary Public

My commission expires:
June 17, 1961

RECEIVED
STATE OF KANSAS COMMISSIONER

FEB 11 1958

CONSERVATION DIVISION
Wichita, Kansas

PLUGGING
FILE SEC 3 T 10 R 26W
BOOK PAGE 81 LINE 32