


Give All Information Completely
Make Required Affidavit
Mail or Deliver Report to:
Conservation Division
State Corporation Commission
212 North Market, Insurance Bldg.
Wichita, Kansas

WELL PLUGGING RECORD

NORTH

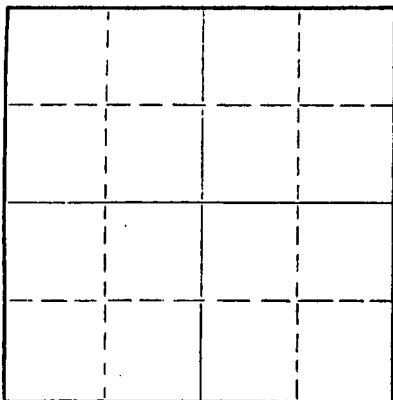

Locate well correctly on above
Section Plat

Sheridan County, Sec. 3 Twp. 10S. Rge. 26W(E) (W)
Location as "NE/CNW%SW%" or footage from lines SE NW NE
Lease Owner John O. Farmer, Inc.
Lease Name Ziegler Well No. 1
Office Address Box 352, Russell, Kansas 67665
Character of Well (completed as Oil, Gas or Dry Hole) Dry Hole
Date well completed 3/22/72 19
Application for plugging filed 3/28/72 19
Application for plugging approved 3/22/72 19
Plugging commenced 3/22/72 19
Plugging completed 3/22/72 10:15 p.m. 19
Reason for abandonment of well or producing formation

If a producing well is abandoned, date of last production 19
Was permission obtained from the Conservation Division or its agents before plugging was commenced? yes

Name of Conservation Agent who supervised plugging of this well W. L. Nichols - Morland, Kansas
Producing formation Depth to top Bottom Total Depth of Well Feet
Show depth and thickness of all water, oil and gas formations.

OIL, GAS OR WATER RECORDS

CASING RECORD

FORMATION	CONTENT	FROM	TO	SIZE	PUT IN	PULLED OUT

Describe in detail the manner in which the well was plugged, indicating where the mud fluid was placed and the method or methods used in introducing it into the hole. If cement or other plugs were used, state the character of same and depth placed, from feet to feet for each plug set.

#1 1225' 110 Cubic Ft.
#2 210' 30 Cubic Ft.
#3 40' 10 Cubic Ft.


RECEIVED
STATE CORPORATION COMMISSION
MAR 29 1972
CONSERVATION DIVISION
Wichita, Kansas
03-29-72

(If additional description is necessary, use BACK of this sheet)
Name of Plugging Contractor John O. Farmer, Inc.
Address Russell, Kansas =

STATE OF Kansas, COUNTY OF Russell, ss.
(employee of owner) or (owner or operator) of the above-described well, being first duly sworn on oath, says: That I have knowledge of the facts, statements, and matters herein contained and the log of the above-described well as filed and that the same are true and correct. So help me God.

(Signature) John O. Farmer
Box 352, Russell, Kansas 67665
(Address)

SUBSCRIBED AND SWORN TO before me this 28th day of March, 1972

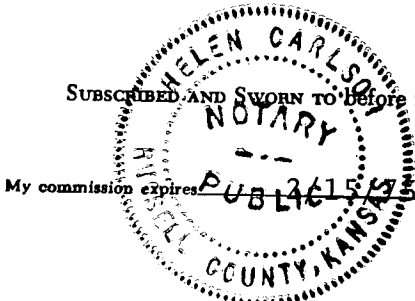

Helen Carlson
Notary Public.


OPERATOR JOHN O. FARMER, INC.

FORMATION RECORD

ADDRESS Box 352, Russell, Ks. 67665

Give detailed description and thickness of all formation drilled through, contents of sand, whether dry, water, oil or gas.

640 Acres
N

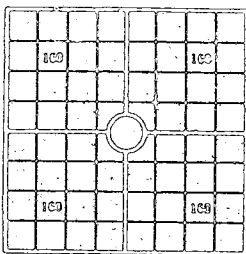

Locate well correctly

COUNTY Sheridan SEC. 3 TWP. 10S RGE. 26W

COMPANY OPERATING John O. Farmer, Inc.

OFFICE ADDRESS Russell, Kansas

DRILLING STARTED 3/16, 1972 DRILLING FINISHED 3/22, 1972

DATE OF FIRST PRODUCTION _____ COMPLETED _____

WELL LOCATED SE 1/4 NW 1/4 NE 1/4, North of South

Line end _____ ft. East of West Line of Quarter Section

Elevation (Relative to sea level) DERRICK FLOOR 2602 GROUND 2597

CHARACTER OF WELL (Oil, gas or dryhole) Dry Hole

OIL OR GAS SANDS OR ZONES

Name	From	To	Name	From	To
1			4		
2			5		
3			6		

Perforating Record if Any

Shot Record

Formation	From	To	No. of Shots	Formation	From	To	Size of Shot

CASING RECORD

Amount Set								Amount Pulled		Packer Record	
Size	Wt.	Thds.	Make	Ft.	In.	Ft.	In.	Size	Length	Depth Set	Make

Liner Record: Amount _____ Kind _____ Top _____ Bottom _____

CEMENTING AND MUDDING

Size	Amount Set		Sacks Cement	Chemical		Method of Cementing	Amount	Mudding Method	Results (See Note)
	Ft.	In.		Gal.	Make				
85/8	202		160						

Note: What method was used to protect sands if outer strings were pulled? _____

NOTE: Were bottom hole plugs used? _____ If so, state kind, depth set and results obtained _____

TOOLS USED

Rotary Tools were used from 0 feet to 4075 Cable tools were used from _____ feet to _____ feet, and from _____ feet to _____ feet, and from _____ feet to _____ feet

Type Rig Rotary

INITIAL PRODUCTION TEST


Describe initial test: whether by flow through tubing or casing or by pumping _____

Amount of Oil Production _____ bbls. Size of choke, if any: _____ Length of test _____ Water

Production _____ bbls. Gravity of oil _____ Type of Pump if pump is used, describe _____

Formation	Top	Bottom	Formation	Top	Bottom
Anhydrite	2242				
Heebner	3825				
Toronto	3846				
Lansing	3864				
Total Depth	4075				
SAMPLE TOPS					
			Shale	700	1140
			Shale & Sand	1140	1600
			Shale	1600	1820
			Sand	1820	2200
			Red Bed	2200	2242
			Anhydrite	2242	2279
			Shale & Shell	2279	2875
			Shale & Lime	2875	2990
			Lime & Shale	2990	3095
			Shale & Lime	3095	3355
			Lime & Shale	3355	3645
			Shale & Lime	3645	3855
			Lime	3855	4076
			TD	4075	

RECEIVED
STATE CORPORATION COMMISSION
MAP 29 1972
CONSERVATION DIVISION
MICHIGAN

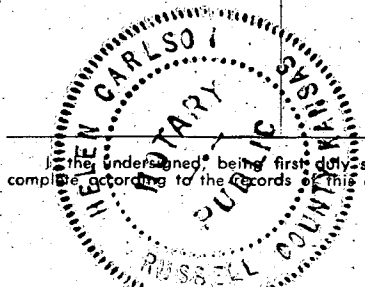

I, the undersigned, being first duly sworn upon oath, state that this well record is true, correct and complete according to the records of this office and to the best of my knowledge and belief.

John O. Farmer
Name and title of representative of company Pres.

Subscribed and sworn to before me this 28th day of March, 1972

My Commission expires 2/15/75

Helen Carlson
Notary Public.

Helen Carlson

FARM NAME ZIEGLER WELL NO. L COUNTY Sheridan SEC. 3 TWP. 10S RGE. 26W

S-173-20303-0000