

15-179-05589-0000

STATE OF KANSAS
STATE CORPORATION COMMISSION

WELL PLUGGING RECORD

Give All Information Completely
Make Required Affidavit
Mail or Deliver Report to:
Conservation Division
State Corporation Commission
211 No. Broadway
Wichita, Kansas

Sheridan County, Sec. 12 Twp. 10 Rge. 26W (E) (W)

Location as "NE/CNW/SW" or footage from lines SE NW SW

Lease Owner C-G Drilling Co. & D. G. Hansen

Lease Name Flagler Well No. 3

Office Address 107 Rule Building, Wichita 2, Kansas

Character of Well (completed as Oil, Gas or Dry Hole) Dry Hole

Date well completed May 6 1959

Application for plugging filed May 6 1959

Application for plugging approved May 6 1959


Plugging commenced May 6 1959

Plugging completed May 6 1959

Reason for abandonment of well or producing formation Too low structurally

If a producing well is abandoned, date of last production 19

Was permission obtained from the Conservation Division or its agents before plugging was commenced? Yes

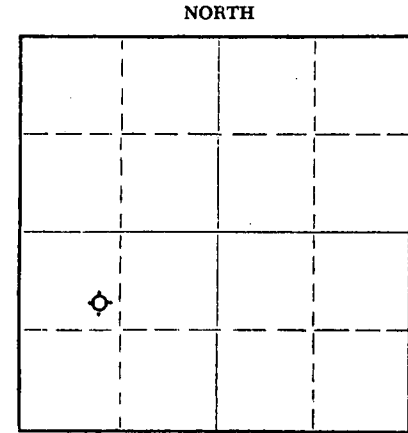

Locate well correctly on above Section Plat

Name of Conservation Agent who supervised plugging of this well Eldon Petty, Hays, Kansas

Producing formation Depth to top Bottom Total Depth of Well 4115 Feet

Show depth and thickness of all water, oil and gas formations.

OIL, GAS OR WATER RECORDS

CASING RECORD

FORMATION	CONTENT	FROM	TO	SIZE	PUT IN	PULLED OUT
				8-5/8"	233.04'	none

Describe in detail the manner in which the well was plugged, indicating where the mud fluid was placed and the method or methods used in introducing it into the hole. If cement or other plugs were used, state the character of same and depth placed, from feet to feet for each plug set.

Filled hole with heavy mud to 600'. Set plug. Put in 20 sacks cement. Filled to 230'. Set plug. Put in 1/2 sack hulls and 20 sacks cement. Filled with heavy mud up to 40'. Set plug. Filled to top with 1/2 sack hulls and 10 sacks cement.

RECEIVED
STATE CORPORATION COMMISSION
MAY 13 1959
CONSERVATION DIVISION
WICHITA, KANSAS
05-13-59

(If additional description is necessary, use BACK of this sheet)

Name of Plugging Contractor C-G Drilling Co.

Address 107 Rule Building, Wichita, Kansas

STATE OF KANSAS, COUNTY OF SEDGWICK, ss. G. F. Galloway


(employee of owner) or (owner or operator) of the above-described well, being first duly sworn on oath, says: That I have knowledge of the facts, statements, and matters herein contained and the log of the above-described well as filed and that the same are true and correct. So help me God.

(Signature) G. F. Galloway 107 Rule Building (Address)

SUBSCRIBED AND SWORN to before me this 11th day of May, 1959

My commission expires May 20, 1959

Vicky Jacobs Notary Public.

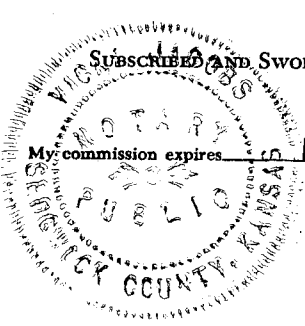

PLUGGING
FILE SEC 12 T 10 R 26W
BOOK PAGE 38 LINE 1

15-179-05589-0000

W E L L L O G

OPERATOR C-G Drilling Co. & D. G. Hansen SEC. 12-10-26
 WELL NAME Flagler #3 LOC. SE NW SW
 TOTAL DEPTH 4115' COUNTY Sheridan
 COMM. April 25, 1959 COMP. May 6, 1959 STATE Kansas
 RIG NO. 1 ELEVATION 2605' K.B.
 CASING: Ran 233.04' (11 jts.) 8-5/8" OD Surface Casing. PRODUCTION: D&A

All measurements taken from the top of rotary bushing.

FROM	TO	FORMATION	DEVIATION FROM VERTICAL	REMARKS:
0	200	Shale		
200	765	Sand-Shale		
765	1750	Shale-Sand		
1750	2145	Shale		
2145	2226	Red Bed		
2226	2265	Anhydrite		
2265	2275	Shell-Shale		
2275	2290	Shale		
2290	2320	Shale-Shell		
2320	2650	Shale	0° - 2500	
2650	2915	Shale-Lime	0° - 2750	
2915	3025	Lime-Shale	0° - 3000	
3025	3165	Shale-Lime		
3165	3804	Lime-Shale	0° - 3250	DST 3834-3856'
3804	3856	Lime		DST 3855-3877'
3856	3877	Lime-Shale		DST 3883-3900'
3877	4020	Lime		DST 3901-3917'
4020	4075	Lime-Shale		DST 3990-4075'
4075	4115	Lime		

RECEIVED
STATE CORPORATION COMMISSION

MAY 13 1959

CONSERVATION DIVISION
Wichita, Kansas

STATE OF KANSAS }
COUNTY OF SEDGWICK } SS.

The undersigned hereby certifies that to the best of his knowledge and belief, the above facts are true and correct.


C-G DRILLING CO.

By G. F. Galloway

SUBSCRIBED AND SWORN TO, BEFORE ME, THIS 11th day of May, 1959.

My Commission expires: May 20, 1959

Vicky Jacobs
Vicky Jacobs - Notary public

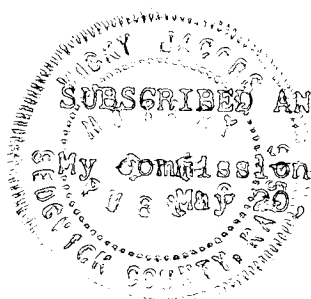

PLUGGING
FILE SEC 12 T/O R26a
BOOK PAGE 38 LINE 8