


STATE OF KANSAS  
STATE CORPORATION COMMISSION

Give All Information Completely  
Make Required Affidavit  
Mail or Deliver Report to:  
Conservation Division  
State Corporation Commission  
211 No. Broadway  
Wichita, Kansas

WELL PLUGGING RECORD

NORTH

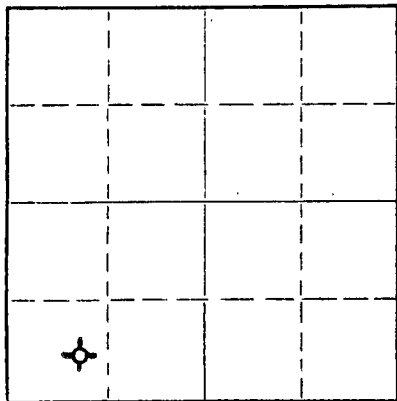

Locate well correctly on above  
Section Plat

Sheridan County, Sec. 12 Twp. 10 Rge. 26 (E) (W) W  
Location as "NE/CNW $\frac{1}{4}$ SW $\frac{1}{4}$ " or footage from lines C E $\frac{1}{2}$  SW $\frac{1}{4}$  SW $\frac{1}{4}$   
Lease Owner C-G Drilling Co. & D. G. Hansen  
Lease Name Flagler Well No. 4  
Office Address 107 Rule Building, Wichita 2, Kansas  
Character of Well (completed as Oil, Gas or Dry Hole) Dry hole  
Date well completed April 25 1960  
Application for plugging filed April 25 1960  
Application for plugging approved April 25 1960  
Plugging commenced April 25 1960  
Plugging completed April 25 1960  
Reason for abandonment of well or producing formation Too low structurally

If a producing well is abandoned, date of last production 19  
Was permission obtained from the Conservation Division or its agents before plugging was commenced? Yes

Name of Conservation Agent who supervised plugging of this well Eldon Petty, Hays, Kansas  
Producing formation Depth to top Bottom Total Depth of Well 4100 Feet  
Show depth and thickness of all water, oil and gas formations.

OIL, GAS OR WATER RECORDS

CASING RECORD

FORMATION	CONTENT	FROM	TO	SIZE	PUT IN	PULLED OUT
				8-5/8"	234.51	None

Describe in detail the manner in which the well was plugged, indicating where the mud fluid was placed and the method or methods used in introducing it into the hole. If cement or other plugs were used, state the character of same and depth placed, from feet to feet for each plug set.

Filled hole with heavy mud to 600'. Set plug. Put in 20 sacks cement. Filled to 230'. Set plug. Put in 1/2 sack hulls and 20 sacks cement. Filled with heavy mud up to 40'. Set plug. Filled to top with 1/2 sack hulls and 10 sacks cement.

RECEIVED  
STATE CORPORATION COMMISSION

MAY 3 1960

CONSERVATION DIVISION  
Wichita, Kansas

(If additional description is necessary, use BACK of this sheet)  
Name of Plugging Contractor C-G Drilling Co.  
Address 107 Rule Building, Wichita 2, Kansas

STATE OF KANSAS, COUNTY OF SEDGWICK, ss.  
G. F. Galloway (employee of owner) or (owner or operator) of the above-described well, being first duly sworn on oath, says: That I have knowledge of the facts, statements, and matters herein contained and the log of the above-described well as filed and that the same are true and correct. So help me God.

(Signature) G. F. Galloway  
107 Rule Building  
(Address)

SUBSCRIBED AND SWORN to before me this 27th day of April, 1960

Vicky Jacobs  
Notary Public.

My commission expires May 20, 1963



W E L L L O G

OPERATOR C-G Drilling Co. & D. G. Hansen SEC. 12-10-26W  
 WELL NAME Flagler #4 LOC. C E $\frac{1}{2}$  SW $\frac{1}{4}$  SW $\frac{1}{4}$   
 TOTAL DEPTH 4100' COUNTY Sheridan  
 COMM. April 17, 1960 COMP. April 25, 1960 STATE Kansas  
 RIG NO. 1 ELEVATION 2604' R.B.

CASING: Ran 234.51' (11 jts.) 8-5/8" OD Surface Casing. PRODUCTION: D & A

All measurements taken from the top of rotary bushing.

FROM	TO	FORMATION	DEVIATION FROM VERTICAL	REMARKS:
0	575	Shale		
575	1705	Sand-Shale		
1705	1805	Shale		
1805	1950	Shell-Shale		
1950	2227	Shale-Red Bed		
2227	2265	Anhydrite		
2265	2455	Shale-Lime		
2455	2690	Shale-Lime	0° - 2500	
2690	3555	Lime-Shale	0° - 2750	
3555	3790	Shale-Lime	0° - 3000	
3790	3849	Lime-Shale	0° - 3250	DST 3827-3849'
3849	3955	Lime	0° - 3500	DST 3848-3872'
3955	4006	Lime-Shale	0° - 3750	DST 3876-3892'
4006	4085	Lime	0° - 4000	DST 3989-4006'
4085	4100	Lime-Shale		

RECEIVED  
STATE CORPORATION COMMISSION

MAY 3 1960

CONSERVATION DIVISION  
Wichita, Kansas

STATE OF KANSAS }  
 COUNTY OF SEDGWICK } SS.

The undersigned hereby certifies that to the best of his knowledge and belief, the above facts are true and correct.

C-G DRILLING CO.

By G. F. Galloway  
 G. F. Galloway

SUBSCRIBED AND SWORN TO, BEFORE ME, THIS 27th day of April, 1960.

My commission expires:  
 May 20, 1963

Vicky Jacobs  
 Vicky Jacobs - Notary public

