


Give All Information Completely
Make Required Affidavit
Mail or Deliver Report to:
Conservation Division
State Corporation Commission
211 No. Broadway
Wichita, Kansas

WELL PLUGGING RECORD

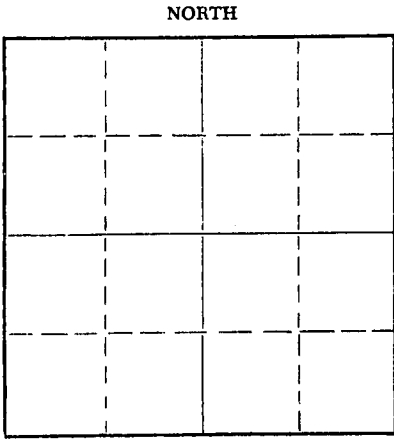

Locate well correctly on above Section Plat

Sheridan County. Sec. 12 Twp. 10S Rge. (E) 26 (W)
Location as "NE/CNW%SW%" or footage from lines NW NW NW
Lease Owner JOHN O. FARMER, INC.
Lease Name SCHREINER Well No. 2
Office Address Russell, Kansas
Character of Well (completed as Oil, Gas or Dry Hole) Dry
Date well completed 4/8 19 59
Application for plugging filed 4/8 19 59
Application for plugging approved 4/8 19 59
Plugging commenced 4/8 19 59
Plugging completed 4/8 19 59
Reason for abandonment of well or producing formation Dry

If a producing well is abandoned, date of last production 19
Was permission obtained from the Conservation Division or its agents before plugging was commenced? yes

Name of Conservation Agent who supervised plugging of this well Fabricius, Hill City, Kansas
Producing formation Depth to top Bottom Total Depth of Well 4060 Feet
Show depth and thickness of all water, oil and gas formations.

OIL, GAS OR WATER RECORDS

CASING RECORD

FORMATION	CONTENT	FROM	TO	SIZE	PUT IN	PULLED OUT
				8-5/8"	160'	None

Describe in detail the manner in which the well was plugged, indicating where the mud fluid was placed and the method or methods used in introducing it into the hole. If cement or other plugs were used, state the character of same and depth placed, from feet to feet for each plug set.

First plug set at 600 feet with 20 sacks cement

Second plug set at 155 feet with 20 sacks cement

Third plug set at 40 feet with 10 sacks cement

RECEIVED
STATE CORPORATION COMMISSION

APR 14 1959

CONSERVATION DIVISION
Wichita, Kansas

(If additional description is necessary, use BACK of this sheet)

Name of Plugging Contractor JOHN O. FARMER, INC.
Address Russell, Kansas


STATE OF Kansas, COUNTY OF Russell, ss.
I, JOHN O. FARMER (employee of owner) or (owner or operator) of the above-described well, being first duly sworn on oath, says: That I have knowledge of the facts, statements, and matters herein contained and the log of the above-described well as filed and that the same are true and correct. So help me God.

(Signature) John O. Farmer
Russell, Kansas (Address)

SUBSCRIBED AND SWORN to before me this 10th day of April, 19 59

My commission expires October 11, 1962

Lucille Kennedy
Notary Public.

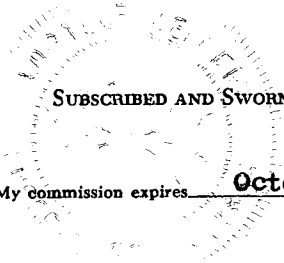

PLUGGING
FILE SEC. 12 T. 10 R. 26W
BOOK PAGE 29 LINE 42

