


STATE OF KANSAS
STATE CORPORATION COMMISSION

WELL PLUGGING RECORD

Give All Information Completely
Make Required Affidavit
Mail or Deliver Report to
Conservation Division
State Corporation Comm.
245 North Water
Wichita, KS 67202

Sheridan County. Sec. 14 Twp. 10S Rge. 26WE/W
Location as "NE/CNW $\frac{1}{4}$ SW $\frac{1}{4}$ " or footage from lines
SE SE SE
Lease Owner Euwer Petroleum Co.
Lease Name WILLSON Well No. 1
Office Address 110 N. Market, Suite 206, Wichita, Ks.
Character of Well (Completed as Oil, Gas or Dry Hole)

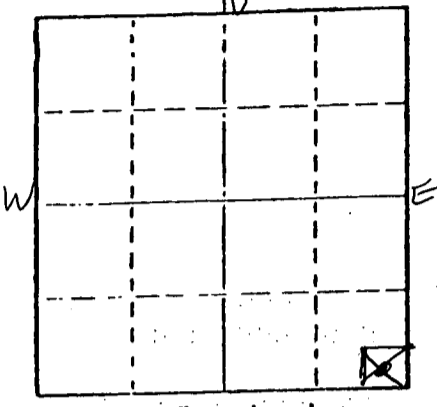

Dry Hole
Date Well completed 3-08 1977
Application for plugging filed (Verbally) 3-08 1977
Application for plugging approved (Verbally) 3-08 1977
Plugging commenced 3-08 1977
Plugging completed 3-08 1977
Reason for abandonment of well or producing formation
No commercial quantity of oil or gas encountered
If a producing well is abandoned, date of last production 19

Was permission obtained from the Conservation Division or its agents before plugging was commenced? Yes

Name of Conservation Agent who supervised plugging of this well Gilbert Balthazor
Producing formation Depth to top Bottom Total Depth of Well
Show depth and thickness of all water, oil and gas formations.

OIL, GAS OR WATER RECORDS CASING RECORD

FORMATION	CONTENT	FROM	TO	SIZE	PUT IN	PULLED OUT

Describe in detail the manner in which the well was plugged, indicating where the mud fluid was placed and the method or methods used in introducing it into the hold. If cement or other plugs were used, state the character of same and depth placed, from feet to feet for each plug set.

T.D. 4070'
Set 1st plug at 1050' with 70 sx.,
2nd plug at 250' with 20 sx.,
40' bridge with 10 sx.

RECEIVED
STATE CORPORATION COMMISSION
MAR 17 1977

Cemented with 50/50 posmix, 6% gel
Plug was down at 8:00 a.m. 3-08-77
State Plugger - Gilbert Balthazor.

(If additional description is necessary, use BACK of this sheet)

Name of Plugging Contractor Abercrombie Drilling, Inc.

STATE OF Kansas COUNTY OF Sedgwick ss.
Jack L. Partridge, Asst. Sec.-Treas. (employee of owner) or (owner or operator) of the above-described

well, being first duly sworn on oath, says: That I have knowledge of the facts, statements, and matters herein contained and the log of the above-described well as filed and that the same are true and correct. So help me God.

(Signature) *Jack L. Partridge*
801 Union Center, Wichita, Kansas 67202
(Address)

SUBSCRIBED AND SWORN TO before me this 14th day of March 1977

My commission expires _____
Kathy S. Goertz
Notary Public.



CONTRACTOR'S WELL LOG

OPERATOR: Euwer Petroleum Co.
 CONTRACTOR: Abercrombie Drilling, Inc.
 WELL NAME: WILLSON #1
 LOCATION: SE SE SE, Section 14-10S-26W
 Sheridan County, Kansas
 SPUD DATE: 3-01-77
 COMPLETION DATE: 3-08-77

0	220	Sand & Clay
220	257	Shale
257	630	Sand & Shale
630	1585	Shale
1585	2176	Shale & Sand
2176	2210	Anhydrite
2210	2860	Shale
2860	3582	Shale & Lime
3582	3745	Lime & Shale
3745	3854	Lime
3854	3870	Lime & Shale
3870	4070	Lime
	4070	Rotary Total Depth

Spud hole at 4:00 p.m. 3-01-77. Drilled 257' of 12 1/4" hole. Ran 7 jts. of 8 5/8" surface casing, tallied 249'. Set at 256' K.B. Cemented with 190 sx. of 60/40 posmix, 2% gel, 3% Ca. Cl. Cement did circulate. Plug was down at 8:00 p.m. 3-01-77.

T.D. 4070', Set 1st plug at 1050' with 70 sx., 2nd plug at 250' with 20 sx., 40' bridge with 10 sx. Cemented with 50/50 posmix, 6% gel. Plug was down at 8:00 a.m. 3-08-77. State Plugger - Gilbert Balthazor.

SAMPLE TOPS:

Anhydrite 2177' (+362)
 B/Anhydrite 2210' (+329)

RECORDED
 STATE COMMISSION
 MAR 17 1977
 COUNTY OF SEDGWICK

STATE OF KANSAS)
) SS
 COUNTY OF SEDGWICK)

Jack L. Partridge, Assistant Secretary-Treasurer of Abercrombie Drilling, Inc., does hereby state that the above and foregoing is a true and correct copy of the log of the WILLSON #1, SE SE SE, Section 14-10S-26W, Sheridan County, Kansas.

ABERCROMBIE DRILLING, INC.

BY: Jack L. Partridge
 Jack L. Partridge, Asst. Sec.-Treas.

Subscribed and sworn to before me, a Notary Public, in and for the aforesaid county and state as of this 14th of March, 1977.

Kathy S. Goertz
 Kathy S. Goertz, Notary Public 3

