

Two (2) copies of this form shall be filed with the Kansas Corporation Commission, 200 Colorado Derby Building, Wichita, Kansas 67202, within thirty (30) days after the completion of a well, regardless of how the well was completed.

F Attach separate letter of request if the information is to be held confidential. If confidential, only file one copy. Information on Side One will be of public record and Side Two will then be held confidential.

Applications must be made on dual completion, commingling, salt water disposal, injection and temporarily abandoned wells.

C Attach one copy only wireline logs (i.e. electrical log, sonic log, gamma ray neutron log, etc.). (Rules 82-2-105 & 82-2-125) KCC# (316) 263-3238.

LICENSE # 8923 EXPIRATION DATE 8/22/84

OPERATOR Wendall Holland API NO. 15-179-20,698

ADDRESS P. O. Box 272 COUNTY Sheridan

Russell, Kansas 67665 FIELD Fuller

** CONTACT PERSON Wendell Holland PROD. FORMATION

PHONE 913-483-3954

PURCHASER LEASE Fuller 'A'

ADDRESS WELL NO. #2

WELL LOCATION ~~XXXXXXXX~~ C W/2 W/2 NE/4


DRILLING CONTRACTOR Rains & Williamson Oil Co., Inc. 2310 Ft. from East Line and

ADDRESS 435 Page Court, 220 W. Douglas 1320 Ft. from North Line of

Wichita, Kansas 67202 the (Qtr.) SEC 10 TWP10S RGE26 (W).

PLUGGING CONTRACTOR Same

ADDRESS

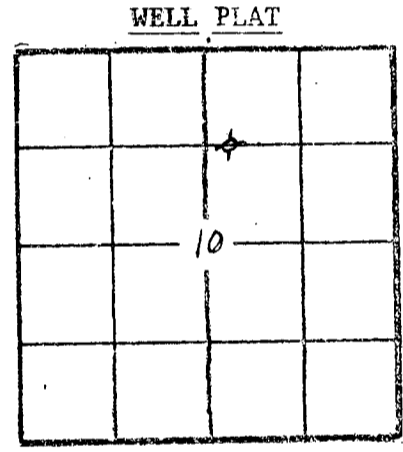

(Office Use Only) KCC [checked] KGS [checked] SWD/REP PLG.

TOTAL DEPTH 4130' PBTD

SPUD DATE 8-25-83 DATE COMPLETED 9-1-83

ELEV: GR 2628 DF KB 2638

DRILLED WITH (CABLE) (ROTARY) (AIR) TOOLS.

DOCKET NO. OF DISPOSAL OR REPRESSURING WELL BEING USED TO DISPOSE OF WATER FROM THIS LEASE

Amount of surface pipe set and cemented 295' DV Tool Used?

THIS AFFIDAVIT APPLIES TO: (Circle ONE) - Oil, Gas, Shut-in Gas, Dry, Disposal, Injection, Temporarily Abandoned, OWWO. Other

ALL REQUIREMENTS OF THE STATUTES, RULES AND REGULATIONS PROMULGATED TO REGULATE THE OIL AND GAS INDUSTRY HAVE BEEN FULLY COMPLIED WITH.

A F F I D A V I T

Wendell Holland, being of lawful age, hereby certifies that:

I am the Affiant, and I am familiar with the contents of the foregoing Affidavit. The statements and allegations contained therein are true and correct.

Wendell Holland (Name)

SUBSCRIBED AND SWORN TO BEFORE ME this 14th day of September, 1983.

[Signature] (NOTARY PUBLIC)

MY COMMISSION EXPIRES: November 12, 1984

** The person who can be reached by phone regarding any questions concerning this information.

RECEIVED SEP 15 1983 CONSERVATION DIVISION Wichita, Kansas

SIDE TWO

ACO-1 WELL HISTORY (X)

OPERATOR Wendall Holland

LEASE Fuller "A" #2

SEC. 10 TWP. 10S RGE. 26 (W)

FILL IN WELL INFORMATION AS REQUIRED:

WELL NO.

Show all important zones of porosity and contents thereof; cored intervals, and all drill-stem tests, including depth interval tested, cushion used, time tool open, flowing and shut-in pressures, and recoveries.

SHOW GEOLOGICAL MARKERS, LOGS RUN, OR OTHER DESCRIPTIVE INFORMATION.

FORMATION DESCRIPTION, CONTENTS, ETC.	TOP	BOTTOM	NAME	DEPTH
Check if no Drill Stem Tests Run.				
Sand & shale	2290			
Shale	2978			
Sand & shale	4130			
RTD	4130			
DST #1 3881-3940 59' anchor Mis-run				
DST#2 3881-3940 59' anchor 45-45-45-45 Rec: 890' slightly muddy water				
DST #3 3993-4060 67' anchor 30-30-30-30 Rec: 10' mud				
DST #4 4062-4130 68' anchor 30-30-30-30 Rec: 65' oil cut mud 45% mud 15% water 20% oil 20% gas				

If additional space is needed use Page 2, Side 2

Report of all strings set— surface, intermediate, production, etc. CASING RECORD (New) or (Used)

Purpose of string	Size hole drilled	Size casing set (in O.D.)	Weight lbs/ft.	Setting depth	Type cement	Sacks	Type and percent additives
Surface	12 1/4"	8 5/8"	24#	295'	Type H 50/50 poz.	100 sx. 100 sx.	

LINER RECORD

PERFORATION RECORD

Top, ft.	Bottom, ft.	Sacks cement	Shots per ft.	Size & type	Depth interval

TUBING RECORD

Size	Setting depth	Packer set at

ACID, FRACTURE, SHOT, CEMENT SQUEEZE RECORD

Amount and kind of material used	Depth interval treated

Date of first production	Producing method (flowing, pumping, gas lift, etc.)	Gravity

Estimated Production -I.P.	Oil bbls.	Gas MCF	Water %	Gas-oil ratio bbls.	CFPB

Disposition of gas (vented, used on lease or sold)

Perforations