

Give All Information Completely  
Make Required Affidavit  
Mail or Deliver Report to:  
Conservation Division  
State Corporation Commission  
211 No. Broadway  
Wichita, Kansas

WELL PLUGGING RECORD

SHERIDAN County. Sec. 2 Twp. 10S Rge. (E) 26 (W)

Location as "NE/CNW&SW&" or footage from lines SW SW NE

Lease Owner KIMBARK EXPLORATION COMPANY

Lease Name VON LINTEL Well No. 1

Office Address

Character of Well (completed as Oil, Gas or Dry Hole) OIL

Date well completed 11/27 1959

Application for plugging filed 9/20 1963

Application for plugging approved 9/20 1963


Plugging commenced 9/24/ 1963

Plugging completed 9/27 1963

Reason for abandonment of well or producing formation DEPLETED

If a producing well is abandoned, date of last production 9/1 1963

Was permission obtained from the Conservation Division or its agents before plugging was commenced? YES

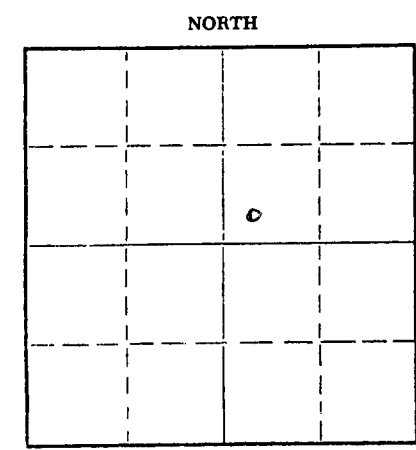

Locate well correctly on above Section Plat

Name of Conservation Agent who supervised plugging of this well W. L. NICHOLS  
Producing formation LANSING Depth to top 3848 Bottom Total Depth of Well 4330 Feet

Show depth and thickness of all water, oil and gas formations.

OIL, GAS OR WATER RECORDS CASING RECORD

FORMATION	CONTENT	FROM	TO	SIZE	PUT IN	PULLED OUT
		0	198	8 5/8	198	0
		0	4070	4 1/2	4070	600'

Describe in detail the manner in which the well was plugged, indicating where the mud fluid was placed and the method or methods used in introducing it into the hole. If cement or other plugs were used, state the character of same and depth placed, from feet to feet for each plug set.

SAND AND ROCK - 4060-3970 - 3 SACKS CEMENT - 3970  
WATER & MUD - 3970-1500'  
SAND BRIDGE @ 1500' - 3 SACKS CEMENT 1500'  
MUD TO 30' - 10 SACKS CEMENT - PLUG 30-0'

RECEIVED  
STATE CORPORATION COMMISSION  
10-21-1963  
OCT 21 1963

CONSERVATION DIVISION  
Wichita, Kansas

(If additional description is necessary, use BACK of this sheet)

Name of Plugging Contractor HAMMOND WELL SERVICE  
Address

STATE OF COLORADO COUNTY OF DENVER, ss.  
W. K. ARBUCKLE (employee of owner) or (owner or operator) of the above-described

well, being first duly sworn on oath, says: That I have knowledge of the facts, statements, and matters herein contained and the log of the above-described well as filed and that the same are true and correct. So help me God.

(Signature) *W. K. Ar buckle*

201 UNIVERSITY BLVD., DENVER 6, COLORADO  
(Address)

SUBSCRIBED AND SWORN TO before me this 17TH day of OCTOBER, 1963

My commission expires August 20, 1964

*Clayton A. ...*  
Notary Public.