

STATE OF KANSAS
STATE CORPORATION COMMISSION


WELL PLUGGING RECORD

Give All Information Completely
Make Required Affidavit
Mail or Deliver Report to:
Conservation Division
State Corporation Commission
800 Biting Building
Wichita, Kansas

Sheridan County, Sec. 2 Twp. 10 Rge. 26 (E) W (W)

Location as "NE/CNW $\frac{1}{4}$ SW $\frac{1}{4}$ " or footage from lines NE NE SE
Lease Owner B & R Drilling, Inc.
Lease Name Carder Well No. 1
Office Address Russell, Kansas
Character of Well (completed as Oil, Gas or Dry Hole) Dry Hole
Date well completed 5/14/52 19____
Application for plugging filed 5/12/52 19____
Application for plugging approved 5/12/52 19____
Plugging commenced 5/13/52 19____
Plugging completed 5/13/52 19____
Reason for abandonment of well or producing formation Dry Hole

NORTH

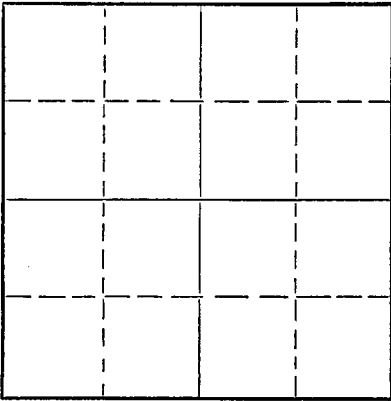

Locate well correctly on above
Section Plat

If a producing well is abandoned, date of last production _____ 19____
Was permission obtained from the Conservation Division or its agents before plugging was commenced? Yes

Name of Conservation Agent who supervised plugging of this well Eldon Petty
Producing formation _____ Depth to top _____ Bottom _____ Total Depth of Well 4617 Feet
Show depth and thickness of all water, oil and gas formations.

OIL, GAS OR WATER RECORDS

CASING RECORD

Formation	Content	From	To	Size	Put In	Pulled Out
				8 5/8	245	None

Describe in detail the manner in which the well was plugged, indicating where the mud fluid was placed and the method or methods used in introducing it into the hole. If cement or other plugs were used, state the character of same and depth placed, from _____ feet to _____ feet for each plug set.

PLUGGING RECORD

Layed down drill pipe. Plugged hole, shoved first plug to 235 feet, put 15 feet of rock on first plug, 1/2 sack of hulls. Mixed 15 sacks of cement, run on first plug. Filled hole to 235 feet with mud. Filled hole to 40 feet with mud. Shoved second plug to 40 feet, put 10 sacks of cement on top plug.

(If additional description is necessary, use BACK of this sheet)

Name of Plugging Contractor _____
Address _____

STATE OF KANSAS, COUNTY OF RUSSELL, ss.
W. A. Michaelis, Jr. (employee of owner) or (owner or operator) of the above-described well, being first duly sworn on oath, says: That I have knowledge of the facts, statements, and matters herein contained and the log of the above-described well as filed and that the same are true and correct. So help me God.

(Signature) W. A. Michaelis, Jr.
Russell, Kansas
(Address)

SUBSCRIBED AND SWORN to before me this 27th day of May, 1952

My commission expires 6-17-54

23-8390-s

6-51-20M

PLUGGING
FILE SEC 2710R
BOOK PAGE 16 OF 14

RECEIVED
STATE CORPORATION COMMISSION
5-28-1952
MAY 28 1952

Notary Public.

CONSERVATION DIVISION
Wichita, Kansas

B & R Drilling, Inc.
Carder No. 1

NE NE SE of Sec. 2-10-26
Sheridan County, Kansas

Total Depth: 4617'
Comm. 4/16/52
Comp. 5/14/52

Casing

Cement

8 5/8" Set @ 245'

135 sacks Monarch

Formation	Depth
Shale-sand	100
Sand-gravel	130
Shale-sand	160
Shale-shells	880
Shale-sand	920
Sand	1060
Sand-shale	1240
Shale-shells	1650
Anhydrite-shale	1695
Shale-shells	1800
Sandy shale	1941
Red Bed-shale-shells	2175
Lime-shale	3090
Lime	3301
Lime-shale	3825
Lime	4325
Lime-shale	4370
Lime-chert	4419
Chert	4432
Lime	4538
Lime-chert	4557
Lime	4617'

STATE OF KANSAS)
) ss
RUSSELL COUNTY)

I hereby certify that the above information is true and correct to the best of my knowledge.

Caro Ref

Subscribed and sworn to before me this 23rd day of May, 1952.

Caro Hummel

Notary Public

My commission expires: 6-17-54.

PLUGGING
FILE SEC Z T 10 R 260
BOOK PAGE 16 LINE 1

RECEIVED
CORPORATION COMMISSION
5-28-1952
MAY 28 1952
CONSERVATION DIVISION
Wichita, Kansas