


Give All Information Completely  
Make Required Affidavit  
Mail or Deliver Report to:  
Conservation Division  
State Corporation Commission  
211 No. Broadway  
Wichita, Kansas

NORTH

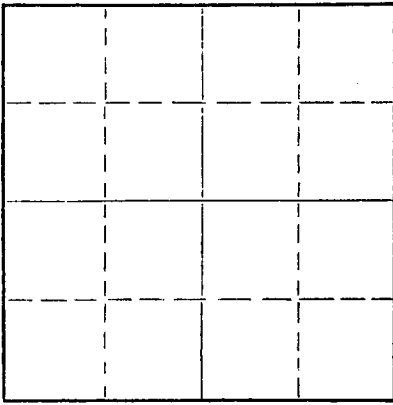

Locate well correctly on above Section Plat

Trego

County. Sec. 10 Twp. 12S Rge. 23W (E) (W)

Location as "NE/CNW/SW" or footage from lines NE NE NE

Lease Owner Imperial Oil of Kansas, Inc.

Lease Name Bender Well No. 2

Office Address Wichita, Kansas

Character of Well (completed as Oil, Gas or Dry Hole) Dry Hole

Date well completed August 25, 1957

Application for plugging filed August 25, 1957

Application for plugging approved August 25, 1957

Plugging commenced August 25, 1957

Plugging completed August 25, 1957

Reason for abandonment of well or producing formation No commercial quantities of oil found.

If a producing well is abandoned, date of last production 19

Was permission obtained from the Conservation Division or its agents before plugging was commenced? Yes

Name of Conservation Agent who supervised plugging of this well Eldon Petty, Hays, Kansas

Producing formation \_\_\_\_\_ Depth to top \_\_\_\_\_ Bottom \_\_\_\_\_ Total Depth of Well 3940 Feet

Show depth and thickness of all water, oil and gas formations.

OIL, GAS OR WATER RECORDS

CASING RECORD

FORMATION	CONTENT	FROM	TO	SIZE	PUT IN	PULLED OUT
				8-5/8"	8-15-57	

Describe in detail the manner in which the well was plugged, indicating where the mud fluid was placed and the method or methods used in introducing it into the hole. If cement or other plugs were used, state the character of same and depth placed, from \_\_\_\_\_ feet to \_\_\_\_\_ feet for each plug set.

Plugged hole at 600 feet with 20 sacks cement, set No. 2 plug at 210' with 20 sacks cement and No. 3 plug at 40' with 10 sacks cement.

09-05-1957

(If additional description is necessary, use BACK of this sheet)

Name of Plugging Contractor Imperial Oil of Kansas, Inc.

Address 780 Fourth National Bldg., Wichita 2, Kansas

STATE OF Kansas, COUNTY OF Sedgwick, ss. Raymond L. Bacon

(employee of owner) or (owner or operator) of the above-described well, being first duly sworn on oath, says: That I have knowledge of the facts, statements, and matters herein contained and the log of the above-described well as filed and that the same are true and correct. So help me God.

(Signature) Raymond L. Bacon

780 Fourth National Bldg., Wichita, Kansas (Address)

SUBSCRIBED AND SWORN TO before me this 4th day of September, 19 57

Louetta M. Duncan  
Louetta M. Duncan Notary Public.

My commission expires December 19, 1960

PLUGGING  
FILE SEC. 10 T. 12 R. 23W  
BOOK PAGE 40 LINE 39

15-195-00292-00-00

DRILLER'S LOG

Imperial Oil of Kansas, Inc.  
780 Fourth National Building  
Wichita 2, Kansas

Bender No. 2  
NE NE NE Sec. 10-12S-23W  
Trego County, Kansas

Total Depth: 3940'

Elevation: 2439' R.B.  
Production: D & A

Commenced: 8-15-57 Completed: 8-25-57

Contractor: Imperial Oil of Kansas, Inc.  
Wichita, Kansas

Casing Record: Set 8-5/8" Surface Pipe at 224' with 175 sacks cement.

Figures indicate bottom of formations:

Sand & Clay	130'		<u>TOPS</u>	
Shale & Shells	224'	Anhydrite		1879' (4 560)
Shale & Sand	1680'	Toronto		3681' (-1242)
Shale	1879'	Lansing		3697' (-1258)
Anhydrite	1925'	Total Depth		3940' (-1501)
Shale & Shells	2420'			
Shale & Lime	3595'			
Lime	3940'			
Total Depth	3940'			

We hereby certify this to be a correct and accurate log of the above described well as shown on the daily drilling reports.

09-05-1957

IMPERIAL OIL OF KANSAS, INC.

By: Harold H. Bacon  
Vice-President

Subscribed and sworn to before me this 4th day of September, 1957.

My Commission Expires:

December 19, 1960

[Signature]  
Notary Public

PLUGGING  
FILE SEC. 10 T. 12 R. 23W  
BOOK PAGE 40 LINE 39