


Give All Information Completely  
Make Required Affidavit  
Mail or Deliver Report to:  
Conservation Division  
State Corporation Commission  
211 No. Broadway  
Wichita, Kansas

WELL PLUGGING RECORD

NORTH

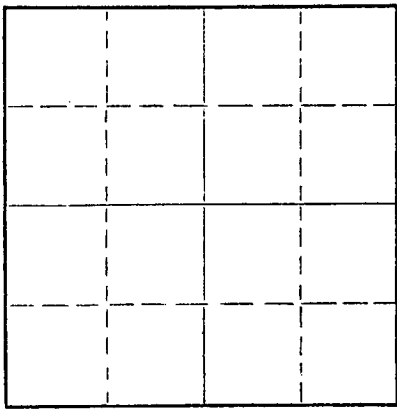

Locate well correctly on above  
Section Plat

Trego County. Sec. 13 Twp. 12S Rge. 23W (E)\_\_\_\_(W)  
Location as "NE/CNWxSWx" or footage from lines. SW SW SE  
Lease Owner Imperial Oil of Kansas, Inc.  
Lease Name Nelson Well No. 1  
Office Address Wichita, Kansas  
Character of Well (completed as Oil, Gas or Dry Hole) Dry Hole  
Date well completed August 24, 19 56  
Application for plugging filed August 10, 19 56  
Application for plugging approved August 10, 19 56  
Plugging commenced August 24, 19 56  
Plugging completed August 24, 19 56  
Reason for abandonment of well or producing formation No oil in commercial quantities found

If a producing well is abandoned, date of last production \_\_\_\_\_ 19\_\_\_\_  
Was permission obtained from the Conservation Division or its agents before plugging was commenced? Yes

Name of Conservation Agent who supervised plugging of this well Mr. Eldon Petty, Hays, Kansas  
Producing formation \_\_\_\_\_ Depth to top \_\_\_\_\_ Bottom \_\_\_\_\_ Total Depth of Well 3940 Feet  
Show depth and thickness of all water, oil and gas formations.

OIL, GAS OR WATER RECORDS

CASING RECORD

FORMATION	CONTENT	FROM	TO	SIZE	PUT IN	PULLED OUT

Describe in detail the manner in which the well was plugged, indicating where the mud fluid was placed and the method or methods used in introducing it into the hole. If cement or other plugs were used, state the character of same and depth placed, from \_\_\_\_\_ feet to \_\_\_\_\_ feet for each plug set.

Plugged back with crushed rock to 3750',  
dumped 4 sacks cement at 3750' with dump  
bailer. Top of cement, 3715'. Filled  
hole with mud to 220', set rock bridge,  
dumped 15 sacks cement. Top of cement  
170'. Filled hole with mud to 35', set  
rock bridge, dumped 10 sacks cement for  
cap.

09-07-1954

(If additional description is necessary, use BACK of this sheet)  
Name of Plugging Contractor Miller Casing Pulling Company  
Address P. O. Box 711, Great Bend, Kansas

STATE OF KANSAS, COUNTY OF SEDGWICK, ss.  
Raymond L. Bacon (employee of owner) or (owner or operator) of the above-described well, being first duly sworn on oath, says: That I have knowledge of the facts, statements, and matters herein contained and the log of the above-described well as filed and that the same are true and correct. So help me God. IMPERIAL OIL OF KANSAS, INC.

(Signature) By: Ray L. Bacon V-P  
903 Union National Bank Bldg. Wichita, Ks.  
(Address)

SUBSCRIBED AND SWORN to before me this 4th day of September, 19 56

Frances E. Barham  
Frances E. Barham Notary Public.

My commission expires April 18, 1959

PLUGGING  
FILE SEC 13 T 12 R 23W  
BOOK PAGE 90 LINE 2

15-195-00135-00-00

DRILLER'S LOG

Imperial Oil of Kansas, Inc.  
903 Union National Bank Building  
Wichita 2, Kansas

Nelson No. 1  
SW SW SE Sec. 13-12S-23W  
Trego County, Kansas

Total Depth: 3940'

Commenced: 7-25-56 Completed: 8-9-56

Elevation: 2430' R.B.  
Production: D & A

Contractor: Imperial Oil of Kansas, Inc.  
Wichita, Kansas

Casing Record: Set 8-5/8" Surface Pipe at 232' with 175 sacks cement.

Figures indicate bottom of formations:

Surface Sand and Shale	210'		
Sand and Shale	230'		
Shale	360'		<u>TOPS</u>
Shale and Sand	1160'	Anhydrite	1847' ( /583)
Sand & Pyrites	1335'	Heebner	3673' (-1243)
Dakota Sand	1590'	Toronto	3692' (-1262)
Shale and Red Bed	1780'	Lansing	3707' (-1277)
Red Bed	1847'	Total Depth	3940' (-1510)
Anhydrite	1889'		
Shale	1934'		
Shale and Shells	2319'		
Shale and Lime	3532'		
Lime	3940'		
Total Depth	3940'		

We hereby certify this to be a correct and accurate log of the above described well as shown on the daily drilling reports.

STATE CORPORATION COMMISSION  
AUG 14 1956  
08-14-1956  
CONSERVATION DIVISION  
Wichita, Kansas

IMPERIAL OIL OF KANSAS, INC.

By: Ray L. [Signature]  
Vice-President

Subscribed and sworn to before me this 13th day of August, 1956.

My Commission Expires:

April 18, 1959

PLUGGING  
FILE SEC 13 T 12 R 23W  
BOOK PAGE 90 LINE 2

Francis E. [Signature]  
Notary Public