


15-033-20559-00-00

WELL PLUGGING RECORD

Give All Information Completely
 Make Required Affidavit

COUNTY Comanche SEC. 3 TWP. 35S RGE. 20W XYW
 Location as in quarters or footage from lines:
C S/2 SW

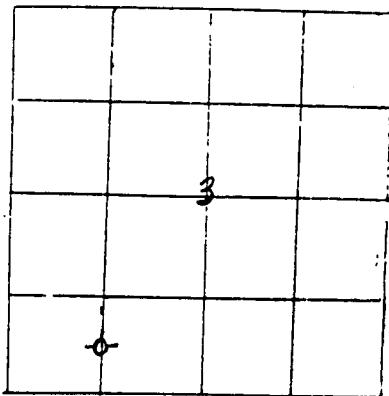

Locate Well
 correctly on above
 Section Platt.

Lease Owner DONALD C. SLAWSON
 Lease Name Box Ranch 'A' Well No. 1
 Office Address 200 Douglas Building Wichita, Kansas 67202
 Character of Well (Completed as Oil, Gas or Dry Hole): Dry Hole
 Date Well Completed May 14, 1982
 Application for plugging filed Yes
 Plugging commenced May 14, 1982
 Plugging completed May 14, 1982
 Reason for abandonment of well or producing formation Dry Hole

Was permission obtained from the Conservation Division or it's
 Agent's before plugging was commenced? Yes

Name of Conservation Agent who supervised plugging of this well Paul Luthi
 Producing formation _____ Depth to top _____ bottom T.D. 5595'

Show depth and thickness of all water, oil and gas formations.

OIL, GAS OR WATER RECORDS

Casing Record

Formation	Content	From surface	To	Size	Put in	Pulled Out
		surface	667'	8 5/8"		

Describe in detail the manner in which the well was plugged, indicating where the mud fluid was placed and the method or methods used in introducing it into the hold. If cement or other plugs were used, state the character of same and depth placed, from _____ feet to _____ feet for each plug set.

1st plug @ 1080' w/60 sx
 2nd plug @ 680' w/40 sx
 Solid Bridge @ 40' w/10 sx
 10 sx in Rat Hole


(If additional description is necessary, use BACK of this sheet)

Name of Plugging Contractor Halliburton Services
Box 579 Great Bend, Kansas 67530

STATE OF KANSAS COUNTY OF SEDGWICK, ss.
William R. Horigan (employee of owner) or (owner or operator) of the
 above-described well, being first duly sworn on oath, says: That I have knowledge of the
 facts, statements, and matters herein contained and the log of the above-described well as
 filed and that the same are true and correct. So help me God.

(Signature) William R. Horigan
William R. Horigan 200 Douglas Building
 (Address) Wichita, KS 67202

SUBSCRIBED AND SWORN TO before me this 20th day of October, 1982

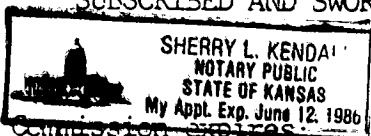

06/12/86

Sherry L. Kendall
 Sherry L. Kendall

RECEIVED
 STATE CORPORATION COMMISSION

OCT 28 1982

CONSERVATION DIVISION
 Wichita, Kansas