

WELL PLUGGING RECORD

Give All Information Completely
Make Required Affidavit
Mail or Deliver Report to:
Conservation Division
State Corporation Commission
211 No. Broadway
Wichita, Kansas

Trego County, Sec 16 Twp. 12 Rge. 23 (E) W. (W)

Location as "NE/CNW%SW%" or footage from lines SE/4SE/4 SW/4

Lease Owner Wick Petroleum Co.

Lease Name Wick Petroleum Co.-Niaden Well No. 1

Office Address WaKeeney, Kansas

Character of Well (completed as Oil, Gas or Dry Hole) _____

Date well completed January 28 19 52

Application for plugging filed February 25 19 58

Application for plugging approved February 25 19 58


Plugging commenced April 14 19 58

Plugging completed May 19 19 58

Reason for abandonment of well or producing formation lack of production

If a producing well is abandoned, date of last production 2-21 1958

Was permission obtained from the Conservation Division or its agents before plugging was commenced? yes.

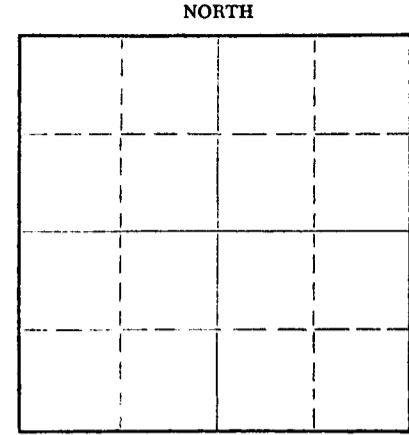

Locate well correctly on above Section Plat

Name of Conservation Agent who supervised plugging of this well Gilbert Leiker

Producing formation _____ Depth to top _____ Bottom _____ Total Depth of Well 3965 Feet

Show depth and thickness of all water, oil and gas formations.

OIL, GAS OR WATER RECORDS

CASING RECORD

FORMATION	CONTENT	FROM	TO	SIZE	PUT IN	PULLED OUT

Describe in detail the manner in which the well was plugged, indicating where the mud fluid was placed and the method or methods used in introducing it into the hole. If cement or other plugs were used, state the character of same and depth placed, from 3965 feet to surface feet for each plug set.

Plug driven down to 3840 feet, and hole filled with sand 3800 feet; four sacks of cement placed in hole with dump baler; All pipe pulled, and hole filled with mud to 250 feet; ten foot rock bridge installed between 250 and 240 ft; twenty sacks of cement poured in hole and hole filled with mud to 35 ft; ten foot rock bridge placed between 35 and 25 feet and well capped with ten sacks of cement to bottom of cellar.

Name of Plugging Contractor Barnes and Sons Plugging Co.,
Address Russell, Kansas.

STATE OF Kansas, COUNTY OF Trego, ss.
W. E. Wickizer (employee of owner) or (owner or operator) of the above-described well, being first duly sworn on oath, says: That I have knowledge of the facts, statements, and matters herein contained and the log of the above-described well as filed and that the same are true and correct. So help me God

(Signature) W. E. Wickizer
WaKeeney, Kansas
(Address)

SUBSCRIBED AND SWORN TO before me this 2nd day of June, 19 58

My commission expires Sept. 10, 1959
Jay H. ... Notary Public.

PLUGGING
Sec. 16, T. 12, R. 23W
BOOK PAGE 85 LINE 16

15-195-00035-00-00


WELL LOG BUREAU—KANSAS GEOLOGICAL SOCIETY
508 East Murdock, Wichita, Kansas

Company- WICK PETROLEUM COMPANY
Farm- Nieden No. 1

SEC. 16 T. 12 R. 23W
SE SE SW

Total Depth. 4387
Comm. 12-27-51 Comp. 1-14-52
Shot or Treated.
Contractor.
Issued. 11-29-52

County Trego
KANSAS

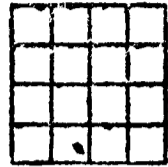

CASING:
8" 195'
5" 4000'

Elevation. 2435

Production. 42 bbls / 4% wtr

Figures Indicate Bottom of Formations.

soil	15
shale	60
sand	70
shale, shells	193
shells	195
shale, shells	840
sand	915
shale, shells	1150
sand, shells	1275
shale, sand	1901
shale, red rock	1929
anhydrite	1970
shale, shells	2321
shale, lime	2565
lime	3190
shale	3265
shale, shells	3365
lime	3436
shale, lime	3510
lime	3990
lime, shale	4033
lime	4080
red rock, shale, lime	4132
lime	4185
shale, sand	4202
lime	4260
shale	4267
lime, shale, sand	4283
cherty conglomerate	4310
congl., shale, shells	4320
congl.	4353
lime Arbuckle	4387.
Total Depth	

Tops: Scout.	
Heebner	3734
Lansing	3768
Base Kansas City	4032
Conglomerate	4283
Arbuckle	4348