


WELL PLUGGING RECORD

Give All Information Completely
Make Required Affidavit
Mail or Deliver Report to:
Conservation Division
State Corporation Commission
800 Bitting Building
Wichita, Kansas

NORTH

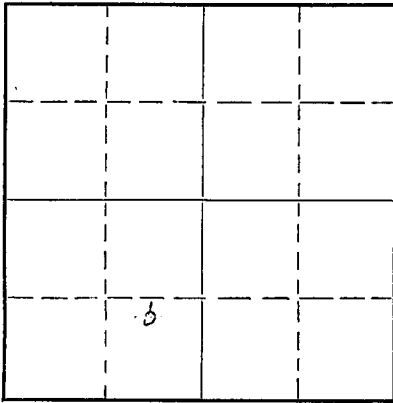

Locate well correctly on above Section Plat

Trego County. Sec. 16 Twp. 12 Rge. 23 (E) (W)
Location as "NE/CNW $\frac{1}{4}$ SW $\frac{1}{4}$ " or footage from lines NW SE SW
Lease Owner W. E. Wickizer
Lease Name Nieden Well No. 2
Office Address Box 775, WaKeeney, Kansas
Character of Well (completed as Oil, Gas or Dry Hole) Dry Hole
Date well completed April 2, 19 56
Application for plugging filed April 2, 19 56
Application for plugging approved April 2, 19 56
Plugging commenced April 3, 19 56
Plugging completed April 3, 19 56
Reason for abandonment of well or producing formation Dry hole
If a producing well is abandoned, date of last production 19
Was permission obtained from the Conservation Division or its agents before plugging was commenced? Yes

Name of Conservation Agent who supervised plugging of this well Mr. Petty
Producing formation Depth to top Bottom Total Depth of Well 404.0 Feet
Show depth and thickness of all water, oil and gas formations.

OIL, GAS OR WATER RECORDS

CASING RECORD

Formation	Content	From	To	Size	Put In	Pulled Out

Describe in detail the manner in which the well was plugged, indicating where the mud fluid was placed and the method or methods used in introducing it into the hole. If cement or other plugs were used, state the character of same and depth placed, from feet to feet for each plug set.

Plugged hole w/ 15 sax of cement on bottom plug and 10 sax of cement on top plug.
Bottom plug set @ 180', used $\frac{1}{2}$ sack hulls, top plug set @ 40' also $\frac{1}{2}$ sack hulls.

05-18-1956
Wichita, Kansas

(If additional description is necessary, use BACK of this sheet)

Correspondence regarding this well should be addressed to W. E. Wickizer
Address Box 775, WaKeeney, Kansas

STATE OF Kansas, COUNTY OF Trego, ss.
(employee of owner) or (owner or operator) of the above-described well, being first duly sworn on oath, says: That I have knowledge of the facts, statements, and matters herein contained and the log of the above-described well as filed and that the same are true and correct. So help me God.

(Signature) *W. E. Wickizer*
(Address)

SUBSCRIBED AND SWORN to before me this 16th day of May 19 56
James H. Hutchinson
Notary Public.

My commission expires 6/23/1957
23-3273-s 4-50-10M

PLUGGING
FILE SEC 16 T 12 R 23W
BOOK PAGE 52 LINE 6

GOLDEN CAT DRILLING and SERVICING COMPANY

15-195-01054-00-00

Office Phone 379

Residence Phone 350

P. O. Box 611

To Kansas Well Log Bureau & State Corporation Commission
508 East Murdock 800 Bitting Bldg.
Wichita, Kansas Wichita, Kansas

Well "Golden #2 (NW SE SW) Sec. 16 Tw. 12 R. 23 Co. Trego

Total Depth: 4040'

Date Commenced: March 21, 1956 Completed: April 2, 1956

Set 220' 8 5/8" surface pipe

0	35	Surface clay and sand
35	220	Shale and shells
220	570	Shale and shells
570	1100	Shale, shells and sand
1100	1250	Sand, shale and pyrite
1250	1315	Shale and shells
1315	1420	Red bed, shells, shale
1420	1930	Sand and red bed
1930	1970	Anhydrite
1970	2370	Shale and shells
2370	2520	Shale and shells
2520	2745	Shale, lime and shells
2745	2955	Lime and shale
2955	3045	Lime and shale
3045	3060	Sand
3060	3175	Lime and shale
3175	3430	Lime and shale
3430	3630	Lime and shale
3630	3784	Lime and shale
3784	3865	Lime
3865	3972	Lime
3972	4040	Lime
4040		TD

RECEIVED
STATE CORPORATION COMMISSION
MAY 18 1956
05-18-1956
CONSERVATION DIVISION
Wichita, Kansas

PLUGGING
FILE SEC 16 T 12 R 23W
BOOK PAGE 52 LINE 6