

STATE OF KANSAS  
STATE CORPORATION COMMISSION


WELL PLUGGING RECORD

OR  
FORMATION PLUGGING RECORD

Strike out upper line  
when reporting plug-  
ging off formations.

Give All Information Completely  
Make Required Affidavit  
Mail or Deliver Report to:  
Conservation Division  
State Corporation Commission  
800 Biting Building  
Wichita, Kansas

Trego County. Sec. 16 Twp. 12 Rge. 22 (E).....(W)  
Location as "NE $\frac{1}{4}$ NW $\frac{1}{4}$ SW $\frac{1}{4}$ " or footage from lines 660 from south 330 W. line  
Lease Owner Salina Drilling Co.  
Lease Name Alex Neiden Well No. 1  
Office Address Box 566 Salina Kansas  
Character of Well (completed as Oil, Gas or Dry Hole) Dry Hole  
Date well completed..... 9 / 28 1952  
Application for plugging filed..... 9 / 28 1952  
Application for plugging approved..... 9 / 28 1952  
Plugging commenced..... 6:30 PM 9/28 52  
Plugging completed..... 10:30 Same 1952  
Reason for abandonment of well or producing formation Low, & dry

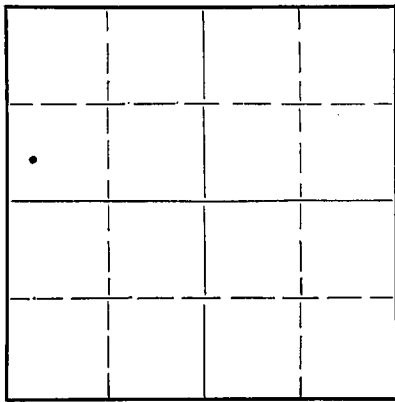

Locate well correctly on above  
Section Plat

If a producing well is abandoned, date of last production..... 19.....  
Was permission obtained from the Conservation Division or its agents before plugging was com-  
menced?..... Yes

Name of Conservation Agent who supervised plugging of this well..... Eldon Petty  
Producing formation Kansas City Line Depth to top 3807 Bottom 4010 Total Depth of Well 4010 Feet  
Show depth and thickness of all water, oil and gas formations.

OIL, GAS OR WATER RECORDS.

CASING RECORD

Formation	Content	From	To	Size	Put In	Pulled Out
Surface Clay		0	30			
Sand		30	153			
Shale & Shells		153	187			
10/3/4	Surface Pipe	0	187		in	

Describe in detail the manner in which the well was plugged, indicating where the mud fluid was placed and the method or methods used in introducing it into the hole. If cement or other plugs were used, state the character of same and depth placed, from.....feet to.....feet for each plug set.

Wooden Plug at 170 feet with 20 sacks of cement poored through drill pipe, Wooden plug at 35 feet with 10 sacks of cement on top of it. Hole full of heavy Mud

REC  
STATE CORP.  
CONSERVATION DIV.  
10-10-1952

(If additional description is necessary, use BACK of this sheet)


Correspondence regarding this well should be addressed to..... Salina Drilling Co.  
Address..... Box 566 Salina Kan.

STATE OF Kansas, COUNTY OF Barton, ss.  
H. B. King (employee of owner) or (owner or operator) of the above-described well,  
being first duly sworn on oath, says: That I have knowledge of the facts, statements, and matters herein contained and the log of the above-  
described well as filed and that the same are true and correct. So help me God.

(Signature) H. B. King  
3306 Jones Great Bend Co. (Address)

SUBSCRIBED AND SWORN to before me this 9 day of Oct 1952  
Leota A. Johnson Notary Public.

My commission expires July 9 1955  
22-2625 2-48-15M

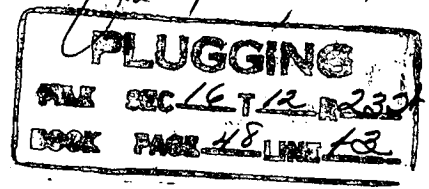

Salina Drilling Co.

Trego County Sec.16 T.12 R. 23

Alex Neiden # 1

From	To	
0	30	Surface Clay
30	153	Sand
153	940	Shale & Shells
940	1740	Sand ,Red Bed & Shells
1740	1915	Red Bed & Shells
1915	1970	Anhydrate
1970	2305	Red Bed & Shells
2305	2410	Shale & Shells
2410	2575	Broken Lime & Shale
2575	3810	Lime & Shale
3810	4010	Lime TD Low & Dry

RECEIVED  
 STATE COMMISSION OF CONSERVATION  
 OCT 10 1952  
 10-10-1952  
 CONSERVATION DIVISION  
 Wichita, Kansas

**PLUGGING**  
 FILE SEC 16 T 12 R 2324  
