


Give All Information Completely
Make Required Affidavit
Mail or Deliver Report to:
Conservation Division
State Corporation Commission
800 Bitting Building
Wichita, Kansas

WELL PLUGGING RECORD

NORTH

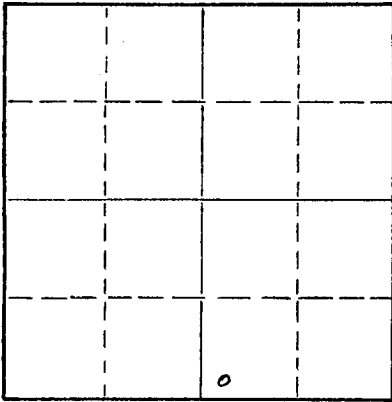

Locate well correctly on above
Section Plat

Trego County. Sec. 15 Twp. 12 Rge. 23 (E) W
Location as "NE/CNW/SW" or footage from lines SW SW SE
Lease Owner Harms-Burt Drilling Company
Lease Name Spitsnaugle Well No. 1
Office Address Box 184, Great Bend, Kansas
Character of Well (completed as Oil, Gas or Dry Hole) Dry Hole
Date well completed August 29 1956
Application for plugging filed " " 1956
Application for plugging approved " " (verbally) 1956
Plugging commenced " " 1956
Plugging completed " " 1956
Reason for abandonment of well or producing formation Dry Hole

If a producing well is abandoned, date of last production _____ 19____
Was permission obtained from the Conservation Division or its agents before plugging was commenced? Yes

Name of Conservation Agent who supervised plugging of this well Milton Galyardt, Box 145, Russell, Kansas
Producing formation _____ Depth to top _____ Bottom _____ Total Depth of Well 3970 Feet
Show depth and thickness of all water, oil and gas formations.

OIL, GAS OR WATER RECORDS

CASING RECORD

FORMATION	CONTENT	FROM	TO	SIZE	PUT IN	PULLED OUT
Surface		0	192	8 5/8"	192	none

Describe in detail the manner in which the well was plugged, indicating where the mud fluid was placed and the method or methods used in introducing it into the hole. If cement or other plugs were used, state the character of same and depth placed, from _____ feet to _____ feet for each plug set.

Filled hole with heavy mud from total depth to 185': 1/3 sack of hulls and plug with 20 sacks of cement on top of plug. Heavy mud to 35' with 1/3 sack hulls, plug and 10 sacks of cement.

(If additional description is necessary, use BACK of this sheet)

Name of Plugging Contractor Harms-Burt Drilling Company
Address Box 184, Great Bend, Kansas

STATE OF Kansas, COUNTY OF Barton, ss.
Allan Harms (employee of owner) or (owner or operator) of the above-described well, being first duly sworn on oath, says: That I have knowledge of the facts, statements, and matters herein contained and the log of the above-described well as filed and that the same are true and correct. So help me God.

(Signature) Allan Harms
Box 184, Great Bend, Kansas
(Address)

SUBSCRIBED AND SWORN TO before me this 14 day of Sept. 1956
Mary E Van Pelt
Notary Public.

My commission expires 1-20-58

PLUGGING
FILE SEC 15 T 12 R23W
BOOK PAGE 95 LINE 6

09-17-1956

15-195-00173-00-00

DRILLERS LOG

Company: Harms-Burt Drilling Company SW SW SE, Section 15-12-23W
Farm: Spitsnaugle #1 Trego County, Kansas
Commenced: August 20, 1956 Completed: August 29, 1956

Elevation: 2421 RB

0 - 30	sandy clay
30 - 150	sand
150 - 845	shale & shells
845 - 970	sand
970 - 1085	shale & sand
1085 - 1615	shale & sand
1615 - 1760	shale & red bed
1760 - 1773	sand
1773 - 1880	sand & shale
1880 - 1915	Anhydrite
1915 - 2400	shale & shells
2400 - 2500	shale & lime
2500 - 2990	lime & shale
2990 - 3105	shale & lime
3105 - 3260	lime & shale
3260 - 3431	lime
3431 - 3523	lime & shale
3523 - 3970	lime
3970 -	T.D/

Set 192' of 8 5/8" surface pipe. Cemented with 175 sacks of common cement and 2 sacks of calcium chloride. Cement circulated.

Tops: Anhydrite	1880
Heebner	3680
Toronto	3700
Lansing K.C.	3716
Base of K.C.	3962

Drill Stem Tests: #1	3795 - 3807	Open 1 hour. Shut in 30 min. Rec. 1140' water. IFP-40# FFP-705# BHP 1085#
#2	3807 - 3830	Open 1 hour. Shut in 20 min. Rec. 435' water. IFP-15# FFP-215# BHP-990#

Ran electric log.


Dry, plugged and abandoned.

State of Kansas, County of Barton, ss

I, Allan Harms, of Harms-Burt Drilling Company, being first duly sworn on oath state: I have knowledge of the facts, statements, and matters herein contained and the same are true and correct.

Subscribed and sworn to be fore me this
My commission expires,

Allan Harms
14 day of Sept. 1956

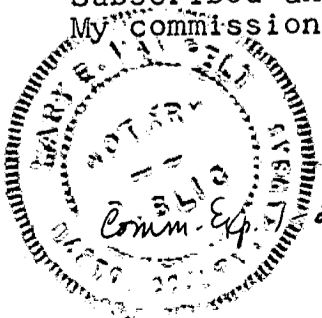

Mary E. Van Pelt
Notary Public

PLUGGING
FILE SEC. 15 T. 12 R. 23W
BOOK PAGE 95 LINE 6

09-17-1956