


WELL PLUGGING RECORD

Give All Information Completely  
Make Required Affidavit  
Mail or Deliver Report to:  
Conservation Division  
State Corporation Commission  
800 Bitting Building  
Wichita, Kansas

NORTH

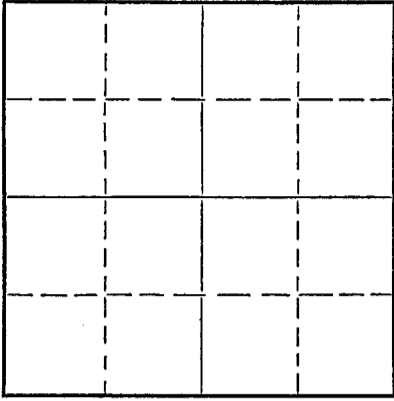

Locate well correctly on above  
Section Plat

Trego County. Sec. 14 Twp. 12 Rge. 23 (E) W (W)  
Location as "NE/CNW $\frac{1}{4}$ SW $\frac{1}{4}$ " or footage from lines SW SW SE  
Lease Owner Anschutz Drilling Company, Inc.  
Lease Name Rhoden Well No. 1  
Office Address 709 Union Nat'l Bk Bldg., Wichita, Kansas  
Character of Well (completed as Oil, Gas or Dry Hole) Dry Hole  
Date well completed 9-15 19 51  
Application for plugging filed 9-15 19 51  
Application for plugging approved 9-15 19 51  
Plugging commenced 9-15 19 51  
Plugging completed 9-15 19 51  
Reason for abandonment of well or producing formation Dry Hole

If a producing well is abandoned, date of last production 19  
Was permission obtained from the Conservation Division or its agents before plugging was commenced? Yes

Name of Conservation Agent who supervised plugging of this well C. D. Stough  
Producing formation Depth to top Bottom Total Depth of Well 4247 Feet  
Show depth and thickness of all water, oil and gas formations.

OIL, GAS OR WATER RECORDS

CASING RECORD

Formation	Content	From	To	Size	Put In	Pulled Out
				8-5/8"	199	-

Describe in detail the manner in which the well was plugged, indicating where the mud fluid was placed and the method or methods used in introducing it into the hole. If cement or other plugs were used, state the character of same and depth placed, from feet to feet for each plug set.

Bottom plug set at 185' with 15 sacks cement  
Top plug set at 40' with 10 sacks cement

SEP 27 1951  
09-27-1951

(If additional description is necessary, use BACK of this sheet)  
Correspondence regarding this well should be addressed to Anschutz Drilling Company, Inc.  
Address 709 Union National Bank Bldg., Wichita, Kansas

STATE OF KANSAS, COUNTY OF SEDGWICK, ss.  
H. R. Jensen (employee of owner) or (owner or operator) of the above-described well,  
being first duly sworn on oath, says: That I have knowledge of the facts, statements, and matters herein contained and the log of the above-described well as filed and that the same are true and correct. So help me God.

(Signature) H. R. Jensen  
709 Union National Bk Bldg., Wichita, Ks.  
(Address)

SUBSCRIBED AND SWORN TO before me this 20th day of September 19 51  
Notary Public

My commission expires January 21, 1954  
23-5091-s 8-50-10M

PLUGGING  
FILE SEC-19T12R 736  
BOOK 210 PAGE 35

15-195-01051-00-00

ANSCHUTZ DRILLING CO., INC.

#1 Rhoden SW SW SE 14-12S-23W  
Trego County, Kansas

0	30	Surface clay
30	110	Sand & shells
110	785	Shale
785	900	Sand
900	1065	Shale & shells
1065	11145	Sand
11145	1350	Shale & red bed
1350	1840	Red bed, shale & shells
1840	1875	Anhydrite
1875	2460	Shale & shells
2460	2595	Lime & shale
2595	2800	Lime
2800	2950	Shale & shells
2950	3065	Shale
3065	3137	Shale & lime
3137	3489	Lime & shale
3489	3505	Lime
3505	3572	Lime Topeka
3572	3640	Lime & shale
3640	3818	Lime
3818	3850	Lime K.C. Lansing
3850	3958	Lime
3958	4020	Lime & shale
4020	4094	Lime
4094	4102	Chert
4102	4128	Lime and shale
4128	4158	Shale & lime
4158	4188	Lime, shale & chert
4188	4240	Cherty Cong.
4240	4247	Chert
4247		Total Depth
		D&A

COMMENCED: 9/1/51  
COMPLETED: 9/15/51

ELEV.: 2396 K.B.

TOPS:

Topeka	3461
Heebner	3667
Lansing	3697
B. K.C.	3956
Congl.	4157

CASING RECORD  
Set 8-5/8" surface pipe  
at 199' with 150 sacks  
cement.

STATE OF KANSAS            )  
                                  ) ss.  
COUNTY OF SEDGWICK    )

ST. ...  
09-27-1951  
SEP 27 1951  
CO. ...

I hereby affirm that the above and foregoing is a true and correct copy of the log of the #1 Rhoden located SW SW SE 14-12S-23W, Trego County, Kansas.

ANSCHUTZ DRILLING COMPANY, INC.

By: *H. R. Jensen*

Subscribed and sworn to before me this 20th day of September, 1951.

*Etienne Becker*  
\_\_\_\_\_  
Notary Public

My commission expires January 21, 1954.



**PLUGGING**  
FILE SEC 14 T 12 S R 23 W  
BOOK PAGE 119 LINE 35