

15-033-10041-00-00

STATE OF KANSAS  
STATE CORPORATION COMMISSION

WELL PLUGGING RECORD

Give All Information Completely  
Make Required Affidavit  
Mail or Deliver Report to:  
Conservation Division  
State Corporation Commission  
212 North Market, Insurance Bldg.  
Wichita, Kansas

Comanche County, Sec. 33 Twp. 34S Rge. 20W (E) (W)

Location as "NE/CNW/SW" or footage from lines C-NE-SW

Lease Owner Sinclair Oil & Gas Company

Lease Name Lawrence V. Robbins Well No. 1

Office Address P. O. Box 521 - Tulsa 2, Oklahoma 74102

Character of Well (completed as Oil, Gas or Dry Hole) Gas

Date well completed January 30, 1964

Application for plugging filed January 21, 1964

Application for plugging approved January 22, 1964


Plugging commenced January 27, 1964

Plugging completed January 30, 1964

Reason for abandonment of well or producing formation Non-Commercial

If a producing well is abandoned, date of last production 1/15 1964

Was permission obtained from the Conservation Division or its agents before plugging was commenced? Yes

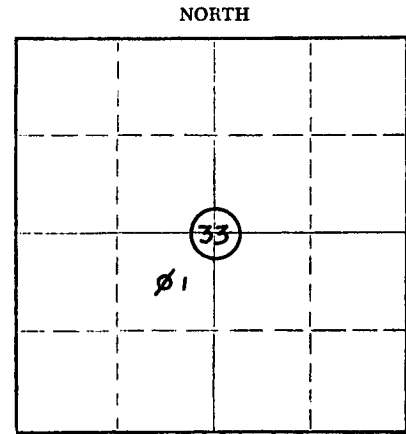

Locate well correctly on above Section Plat

Name of Conservation Agent who supervised plugging of this well A. Elving

Producing formation Morrow Sand Perfs Depth to top 5437' Bottom 5443' Total Depth of Well 5571 Feet

Show depth and thickness of all water, oil and gas formations.

OIL, GAS OR WATER RECORDS

CASING RECORD

FORMATION	CONTENT	FROM	TO	SIZE	PUT IN	PULLED OUT
Morrow Sand	Gas	5437'	5443'	13-3/8"	35'	None
				8-5/8"	645'	None
				4-1/2"	5571'	4570' Pulled

Describe in detail the manner in which the well was plugged, indicating where the mud fluid was placed and the method or methods used in introducing it into the hole. If cement or other plugs were used, state the character of same and depth placed, from \_\_\_\_\_ feet to \_\_\_\_\_ feet for each plug set.

Dumped sand plug at 5400 feet. Dumped 10 sacks cement plug. Top of plug at 5370'. Shot pipe @ 4570'. Pulled 11 1/4 joints (4570') of 4 1/2" O.D. casing. Dumped 10' rock plug. Top of plug 300'. Dumped 25 sacks cement plug. Top of cement plug @ 222'. Dumped mud to 40' of surface. Dumped 10' rock plug & 10 sacks cement plug to surface. Completed plugging gas well at 4:30 P.M. 1/30/64, as per instructions of Mr. A. Elving, State Plugging Agent.

RECEIVED  
STATE CORPORATION COMMISSION  
2-7-1964  
FEB 7 1964  
CONSERVATION DIVISION  
Wichita, Kansas

(If additional description is necessary, use BACK of this sheet)  
Name of Plugging Contractor Knight Casing Pulling Company  
Address P. O. Box 405 - Chase, Kansas 67524

STATE OF Kansas, COUNTY OF Barton, ss.  
J. F. Donham (employee of owner) or (owner or operator) of the above-described

well, being first duly sworn on oath, says: That I have knowledge of the facts, statements, and matters herein contained and the log of the above-described well as filed and that the same are true and correct. So help me God

(Signature) J. F. Donham

Route # 1 - Great Bend, Kansas 67530 (Address)

SUBSCRIBED AND SWORN TO before me this 6th day of February, 1964

Notary Public (Signature)

My commission expires July 12, 1967




WELL LOG BUREAU--KANSAS GEOLOGICAL SOCIETY  
508 East Murdock, Wichita, Kansas

Company. SINCALIR OIL & GAS  
Farm. Robbins No. 1

SEC. 33 T. 34 R. 20W  
C NE SW

Total Depth. 5571'  
Comm. 12-10-63 Comp. 1-2-64  
Shot or Treated.  
Contractor. D & M. Drilling  
Issued. 3-28-64

County Comanche  
KANSAS

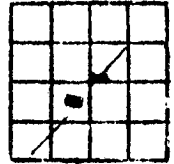

Elevation. 1720' GR

Production. Dry

CASING:

8 5/8" 658' cem w/650 sx.  
4 1/2" 5570' cem w/150 sx.

Figures Indicate Bottom of Formations

sand, shale & shells	100
shale & Anhydrite	342
shells	645
shale, shells & clay	1560
shale & shells	1924
shale	2080
lime & shale	2653
lime	2843
lime & shale	3410
shale	3602
lime & shale	3830
shale	4269
lime & shale	4390
lime & chert	4420
lime & shale	4555
lime	4685
lime & shale	4751
lime	4846
lime & shale	5388
lime	5420
lime & shale	5536
lime	5570
lim e ?	5571 RTD
Total Depth	

TOPS: LCG	
Heebner	4264
Lansing	4467
Marmaton	5054
Cherokee Shale	5192
Morrow Shale	5340
Morrow Sand	5392
St. Geneva	5458

RECEIVED  
STATE CORPORATION COMMISSION  
7-16-1964  
JUL 16 1964  
CONSERVATION DIVISION  
Wichita, Kansas