

15-129-20098-2000

STATE OF KANSAS  
STATE CORPORATION COMMISSION

Form CP-4

Give All Information Completely  
Make Required Affidavit  
Mail or Deliver Report to:  
Conservation Division  
State Corporation Commission  
212 No. Market  
Wichita, Kansas

WELL PLUGGING RECORD

Morton County, Sec. 3 Twp. 34S Rge. (E) 41 (W)

Location as "NE/CNW/SW" or footage from lines C-SE-SW

Lease Owner Ran Ricks

Lease Name #1 U.S.A. Well No.

Office Address 425 Cravens Building

Character of Well (completed as Oil, Gas or Dry Hole) Dry

Date well completed September 29, 1972 19

Application for plugging filed September 28, 1972 19

Application for plugging approved September 28, 1972 19


Plugging commenced September 28, 1972 19

Plugging completed September 29, 1972 19

Reason for abandonment of well or producing formation Dry

If a producing well is abandoned, date of last production 19

Was permission obtained from the Conservation Division or its agents before plugging was commenced?

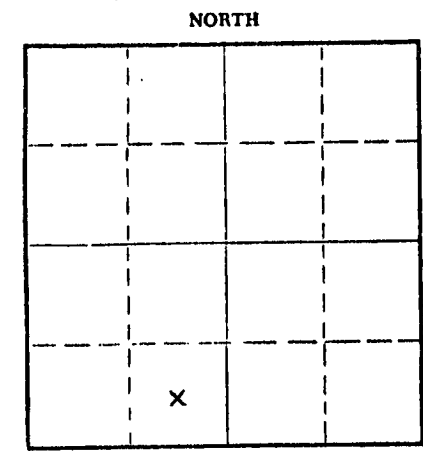

Locate well correctly on above Section Plat

Name of Conservation Agent who supervised plugging of this well Edgar Eyes

Producing formation Depth to top Bottom Total Depth of Well 5600 Feet

Show depth and thickness of all water, oil and gas formations.

OIL, GAS OR WATER RECORDS

CASING RECORD

FORMATION	CONTENT	FROM	TO	SIZE	PUT IN	PULLED OUT
				8 5/8"	1514'	

Describe in detail the manner in which the well was plugged, indicating where the mud fluid was placed and the method or methods used in introducing it into the hole. If cement or other plugs were used, state the character of same and depth placed, from feet to feet for each plug set.

50 sx. plug at 1476'  
15 sx. plug 40' - 0  
3 sx. in rat hole

RECEIVED  
STATE CORPORATION COMMISSION  
NOV 3 1972  
CONSERVATION DIVISION  
Wichita, Kansas

(If additional description is necessary, use BACK of this sheet)

Name of Plugging Contractor Leben Drilling, Inc.  
Address Wichita, Kansas

STATE OF Oklahoma, COUNTY OF Oklahoma, ss.  
Ran Ricks, Jr., Operator (employee of owner) or (owner or operator) of the above-described

well, being first duly sworn on oath, says: That I have knowledge of the facts, statements, and matters herein contained and the log of the above-described well as filed and that the same are true and correct. So help me God.

(Signature) [Signature]  
425 Cravens Bldg., Okla. City, Okla. 73102 (Address)


SUBSCRIBED AND SWORN TO before me this 2nd day of November, 1972

My commission expires 3-19-74  
Debrah Martin Notary Public.

WELL LOG

Company Zenith Drilling  
Contractor Leben Drilling, Inc.  
Farm U.S.A. #1  
Total Depth 5600'  
Commenced Sept. 15, 1972  
Completed Sept. 29, 1972

Sec. 3 T. 34S R. 41W  
Loc. C SE SW  
County Morton Co. KS  
Casing 8 5/8"  
Production

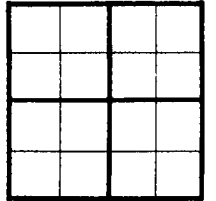

Figures Indicate Bottom of Formations

0- 235	Sand & Clay
235- 640	Sand & Red Bed
640-1065	Red Bed-Anhydrite-sand
1065-1200	Sand
1200-1465	Red Bed
1465-1481	Anhydrite
1481-1630	Red Bed
1630-2070	Red Bed - Shale
2070-2260	Shale-Lime
2260-4880	Lime-Shale
4880-4920	Sand-Lime
4920-4970	Lime-Shale-Sand
4970-5491	Lime-Shale
5491-5560	Shale-Lime
5560-5600	Lime-Shale

RECEIVED  
STATE CORPORATION COMMISSION  
OCT 5 1972  
CONSERVATION DIVISION  
Wichita, Kansas

State of Oklahoma  
County of Oklahoma } SS

I, Leslie Kite of Leben Drilling, Inc., upon oath state that the above and foregoing is a true and correct copy of the log of the #1 U.S.A. Well.

Leslie Kite

Subscribed and sworn to before me this 3rd day of October, 1972

My Commission Expires: 5/23/76

Brenda Kay Swink