

STATE OF KANSAS  
STATE CORPORATION COMMISSION

WELL PLUGGING RECORD

Give All Information Completely  
Make Required Affidavit  
Mail or Deliver Report to  
Conservation Division  
State Corporation Comm.  
245 North Water  
Wichita, KS 67202

Sheridan County, Sec. 10 Twp. 10S Rge. 26 E/W  
Location as "NE/CNW/SW" or footage from lines

SW SW NE  
Lease Owner Rains & Williamson Oil Co., Inc.  
Lease Name Fuller "A" Well No. #1

Office Address 435 Page Court, 220 W. Douglas, Wichita, Ks.  
Character of Well (Completed as Oil, Gas or Dry Hole)

Dry Hole

Date Well completed 2-3-82 19  
Application for plugging filed 2-3-82 19  
Application for plugging approved 2-3-82 19  
Plugging commenced 2-3-82 19  
Plugging completed 2-3-82 19

Reason for abandonment of well or producing formation  
Commercial quantities of oil not found


If a producing well is abandoned, date of last production 19.

Was permission obtained from the Conservation Division or its agents before plugging was commenced? Yes

Name of Conservation Agent who supervised plugging of this well Mr. Goodrow

Producing formation Depth to top Bottom Total Depth of Well 4344'

Show depth and thickness of all water, oil and gas formations.

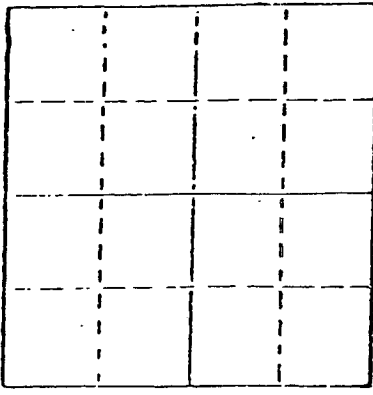

Locate well correctly on above Section Plot

OIL, GAS OR WATER RECORDS

CASING RECORD

FORMATION	CONTENT	FROM	TO	SIZE	PUT IN	PULLED OUT
				8 5/8"	292'	None

Describe in detail the manner in which the well was plugged, indicating where the mud fluid was placed and the method or methods used in introducing it into the hold. If cement or other plugs were used, state the character of same and depth placed, from feet to feet for each plug set.

- Plug @ 1300' w/70 sx.
- Plug @ 300' w/40 sx.
- Plug @ 40' w/10 sx.
- Rat Hole 10 sx.

(If additional description is necessary, use BACK of this sheet)

Name of Plugging Contractor Rains & Williamson Oil Co., Inc.

STATE OF Kansas COUNTY OF Sedgwick, ss.  
Wilson Rains, President of Rains & Williamson Oil Co., (employee of owner) or (owner or operator) of the above-described well, being first duly sworn on oath, says: That I have knowledge of the facts, statements, and matters herein contained and the log of the above-described well as filed and that the same are true and correct. So help me God.

(Signature) Wilson Rains  
435 Page Court, 220 W. Douglas, Wichita, Ks. 67202  
(Address)

SUBSCRIBED AND SWORN TO before me this 10 day of February, 1982



Juanita M. Green  
Notary Public.

RECEIVED  
STATE CORPORATION COMMISSION  
2-10-1982  
FEB 10 1982

CONSERVATION DIVISION  
Wichita, Kansas

DRILLER'S LOG

COMPANY: Rains & Williamson Oil Co., Inc. SEC. 10 T. 10S R. 26W  
 WELL NAME: Fuller "A" #1 LOC. SW SW NE  
 COUNTY: Sheridan  
 RIG NO. #4  
 TOTAL DEPTH 4344' ELEVATION 2622 GL 2627 KB  
 COMMENCED: 1-23-82 COMPLETED: 2-3-82  
 CONTRACTOR: Rains & Williamson Oil Co., Inc.  
 CASING RECORD:  
 SURFACE: 8 5/8" @ 292' w/165 sx. 60/40 poz.  
 PRODUCTION: D&A

LOG  
 (Figures Indicate Bottom of Formations)


Shale	42
Shale & Sand	2269
Shale & Lime	2770
Lime	4344
<u>ROTARY TOTAL DEPTH</u>	<u>4344</u>

RECEIVED  
 STATE CORPORATION COMMISSION  
 2-10-1982  
 FEB 10 1982  
 CONSERVATION DIVISION  
 Wichita, Kansas

STATE OF Kansas )  
 COUNTY OF Sedgwick ) SS:

I, Wilson Rains, President of Rains & Williamson Oil Co., Inc.  
 upon oath state that the above and foregoing is a true and correct copy of the log of the  
Fuller "A" #1 well.

Wilson Rains  
 Wilson Rains

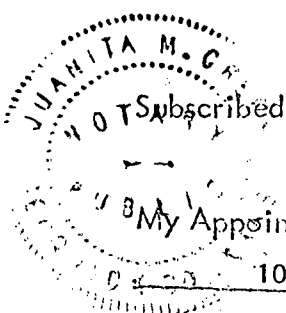

Subscribed and sworn to before me this 10 day of February, 1982.

Juanita M. Green  
 Juanita M. Green

My Appointment Expires:  
10-4-83