

NOTICE OF INTENTION TO DRILL

(see rules on reverse side)

Starting Date June 1, 1986 month day year

API Number 15- 193-20,407-0000 East

OPERATOR: License # 9041

Section of NE NW NW Sec. 24 Twp. 10 S, Rg. 31 X West

Name Joseph H. Strabala

Address 312 East Uintah

City/State/Zip Colorado Springs, CO 80903

Contact Person Joseph H. Strabala

Phone (303) 635-7807

4630! Ft. from South Line of Section

4180! Ft. from East Line of Section

(Note: Locate well on Section Plat on reverse side)

Nearest lease or unit boundary line 650 feet

County Thomas

CONTRACTOR: License # 5422

Lease Name Delzeit Well # 1

Name Abercrombie Drilling, Inc.

City/State Wichita, Kansas 67202

Ground surface elevation feet MSL

Domestic well within 330 feet: —yes X no

Municipal well within one mile: —yes X no

Well Drilled For: Well Class: Type Equipment:

X Oil SWD Infield X Mud Rotary

Gas Inj Pool Ext Air Rotary

OWWO Expl X Wildcat Cable

Depth to bottom of fresh water 180'

Depth to bottom of usable water 1600'

Surface pipe by Alternate: 1 2 X

Surface pipe planned to be set 225'

Conductor pipe required None

Projected Total Depth 4600' feet

Formation Miss.

If OWWO: old well info as follows:

Operator

Well Name

Comp Date Old Total Depth

I certify that well will comply with K.S.A. 55-101, et seq., plus eventually plugging hole to KCC specifications.

Date 5-13-86 Signature of Operator or Agent Joseph H. Strabala Title Operator

For KCC Use:

Conductor Pipe Required feet; Minimum Surface Pipe Required 225 feet per Alt. X 2

This Authorization Expires 11-22-86 Approved By 5-22-86


Handwritten signature: RCH/KONE

Must be filed with the K.C.C. five (5) days prior to commencing well
This card void if drilling not started within six (6) months of date received by K.C.C.

Important procedures to follow:

1. Notify District office before setting surface casing.
2. Set surface casing by circulating cement to the top.
3. File completion forms ACO-1 with K.C.C. within 90 days of well completion, following instructions on ACO-1, side 1, and including copies of wireline logs.
4. Notify District office 48 hours prior to old well workover or re-entry.
5. Prior to filing Intent, prepare a proposed plugging plan in case well is D & A, then obtain approval of plan when calling district office prior to setting surface pipe.
6. Submit plugging report (CP-4) to K.C.C. after plugging is completed.
7. Obtain an approved injection docket number before disposing of salt water.
8. Notify K.C.C. within 10 days when injection commences or terminates.
9. If an alternate 2 completion, cement in the production pipe from below any usable water to surface within 120 days of spud date.

A Regular Section of Land 1 Mile = 5,280 Ft.

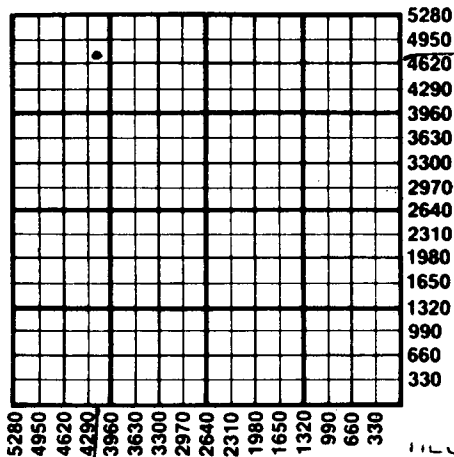

RECEIVED
STATE CORPORATION COMMISSION

5-22-86
MAY 22 1986

CONSERVATION DIVISION
Wichita, Kansas

State Corporation Commission of Kansas
Conservation Division
200 Colorado Derby Building
Wichita, Kansas 67202
(316) 263-3238