

NOTICE OF INTENTION TO DRILL

(see rules on reverse side)

✓ LA

Expected Spud Date... 7-1-88
month day year

API Number 15-193-20,465-0000
East

OPERATOR: License # 4767
Name Ritchie Exploration, Inc.
Address 125 N. Market, Suite 1000
City/State/Zip Wichita, KS 67202
Contact Person Rocky Milford
Phone 316-267-4375

SE NW SW Sec. 24 Twp. 10 S, Rg. 31
1650 Ft. from South Line of Section
4290 Ft. from East Line of Section

(Note: Locate well on Section Plat on reverse side)

CONTRACTOR: License # 6033
Name Murfin Drilling Company
City/State Wichita, KS

Nearest lease or unit boundary line 990 feet
County Thomas
Lease Name Robben Well # 2

Well Drilled For: Well Class: Type Equipment:
 Oil Storage Infield Mud Rotary
 Gas Inj Pool Ext. Air Rotary
 OWWO Expl Wildcat Cable

Ground surface elevation 2903 feet MSL
Domestic well within 330 feet: yes no
Municipal well within one mile: yes no

If OWWO: old well info as follows:
Operator
Well Name
Comp Date Old Total Depth

Depth to bottom of fresh water 150
Depth to bottom of usable water 1500-1700
Surface pipe by Alternate: 1 2

I certify that well will comply with K.S.A. 55-101, et seq., plus eventually plugging hole to KCC specifications.
Date 6-24-88 Signature of Operator or Agent Rocky Milford Title geologist

For KCC Use:
Conductor Pipe Required feet; Minimum Surface Pipe Required 200 feet per Alt. 10 2
This Authorization Expires 12-27-88 Approved By P.H. 6-27-88


EFFECTIVE DATE: 7-2-88

Must be filed with the K.C.C. five (5) days prior to commencing well
This card void if drilling not started within six (6) months of date received by K.C.C.

Important procedures to follow:

1. Notify District office before setting surface casing.
2. Set surface casing by circulating cement to the top.
3. File completion forms ACO-1 with K.C.C. within 120 days of well spud date, following instructions on ACO-1, side 1, and including copies of wireline logs.
4. Notify District office 48 hours prior to old well workover or re-entry.
5. Prior to filing Intent, prepare a proposed plugging plan in case well is D & A, then obtain approval of plan when calling district office prior to setting surface pipe.
6. Submit plugging report (CP-4) to K.C.C. after plugging is completed.
7. Obtain an approved injection docket number before disposing of salt water.
8. Notify K.C.C. within 10 days when injection commences or terminates.

A Regular Section of Land 1 Mile = 5,280 Ft.

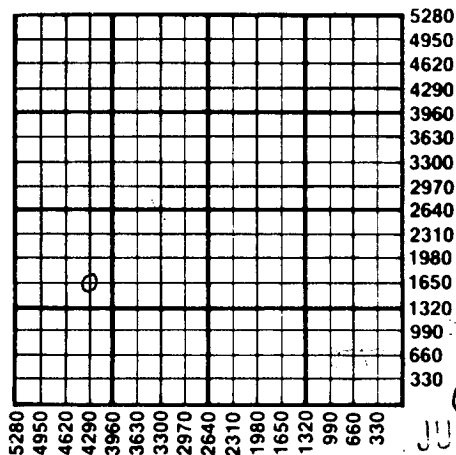

6-27-88

JUN 27 1988

If an alternate 2 completion, cement in the production pipe from below any usable water to surface within 120 days of spud date.

CONSERVATION DIVISION

State Corporation Commission of Kansas
Conservation Division
200 Colorado Derby Building
Wichita, Kansas 67202-1212
(316) 263-3238