


STATE OF KANSAS  
STATE CORPORATION COMMISSION

WELL PLUGGING RECORD

Give All Information Completely  
Make Required Affidavit  
Mail or Deliver Report to  
Conservation Division  
State Corporation Comm.  
245 North Water  
Wichita, KS 67202

Gove County. Sec. 17 Twp. 12 S Rge. 30 E/W  
Location as "NE/CNW $\frac{1}{4}$ SW $\frac{1}{4}$ " or footage from lines  
W/2 NW SE  
Lease Owner Zenith Drilling Company  
Lease Name ZERR Well No. 1  
Office Address 200 West Douglas, Wichita, Kansas 67202  
Character of Well (Completed as Oil, Gas or Dry Hole) Dry hole

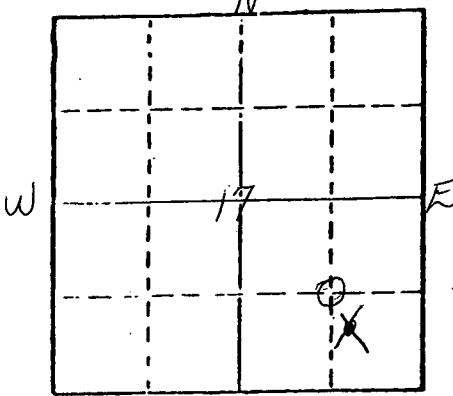

Locate well correctly on above Section Plat

Name of Conservation Agent who supervised plugging of this well Gilbert Balthazor  
Producing formation \_\_\_\_\_ Depth to top \_\_\_\_\_ Bottom \_\_\_\_\_ Total Depth of Well 4225  
Show depth and thickness of all water, oil and gas formations.

Date Well completed July 18, 1977  
Application for plugging filed (verbally) July 18, 1977  
Application for plugging approved (verbally) July 18, 1977  
Plugging commenced July 18, 1977  
Plugging completed July 18, 1977  
Reason for abandonment of well or producing formation  
No commercial quantity of gas or oil encountered.  
If a producing well is abandoned, date of last production 19

Was permission obtained from the Conservation Division or its agents before plugging was commenced? Yes

OIL, GAS OR WATER RECORDS

CASING RECORD

FORMATION	CONTENT	FROM	TO	SIZE	PUT IN	PULLED OUT

Describe in detail the manner in which the well was plugged, indicating where the mud fluid was placed and the method or methods used in introducing it into the hold. If cement or other plugs were used, state the character of same and depth placed, from \_\_\_\_\_ feet to \_\_\_\_\_ feet for each plug set.

Set 1st plug at 950' with 70 sacks  
2nd plug at 240' with 20 sacks  
3rd plug at 40' with 10 sacks

Plug was down at 8:00 a.m., July 18, 1977.

07-26-1977


(If additional description is necessary, use BACK of this sheet)

Name of Plugging Contractor Abercrombie Drilling, Inc.

STATE OF KANSAS COUNTY OF SEDGWICK, ss.  
Jack L. Partridge, Ass't. Secretary-Treasurer (employee of owner) or (owner or operator) of the above-described well, being first duly sworn on oath, says: That I have knowledge of the facts, statements, and matters herein contained and the log of the above-described well as filed and that the same are true and correct. So help me God.

(Signature) Jack L. Partridge  
801 Union Center, Wichita, Kansas 67202  
(Address)

SUBSCRIBED AND SWORN TO before me this 21st day of July, 1977

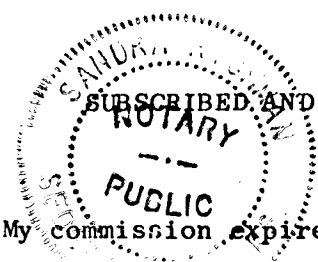

Sandra Richman  
Sandra Richman Notary Public.

OPERATOR: Zenith Drilling Company  
 CONTRACTOR: Abercrombie Drilling, Inc.  
 WELL NAME: ZERR #1  
 LOCATION: W/2 NW SE Section 17-12S-30W  
 Gove County, Kansas  
 SPUD DATE: July 9, 1977  
 COMPLETION DATE: July 18, 1977

0	150	Surface clay & sand
150	265	Shale
265	2349	Sand & shale
2349	2379	Anhydrite
2379	2595	Sand & shale
2595	2868	Shale & shells
2868	3233	Shale
3233	3915	Lime & shale
3915	4225	Lime
	4225	Rotary Total Depth

Spud hole at 6:30 p.m., July 9, 1977. Drilled 265' of 12 1/4" hole. Ran 6 joints of 8-5/8" surface casing, set at 253.53'. Cemented with 180 sacks common cement, 2% gel, 3% CaCl. Halliburton Cement. Plug was down at 12:00 midnight, July 9, 1977. Cement did circulate.

R.T.D. 4225'. Set 1st plug at 950' with 70 sacks, 2nd plug at 240' with 20 sacks, 3rd plug at 40' with 10 sacks. Cemented with 50/50 posmix, 6% gel. Plug was down at 8:00 a.m., July 18, 1977. State plugger - Gilbert Balthazor.

SAMPLE TOPS:

Anhydrite 2350' (+535)  
 B/Anhydrite 2379' (+506)

STATE OF KANSAS )  
 ) ss  
 COUNTY OF SEDGWICK )


07-26-1977

Jack L. Partridge, Assistant Secretary-Treasurer of Abercrombie Drilling, Inc., does hereby state that the above and foregoing is a true and correct copy of the log of the Zerr #1, W/2 NW SE Section 17-12S-30W, Gove County, Kansas.

ABERCROMBIE DRILLING, INC.

BY Jack L. Partridge  
 Jack L. Partridge  
 Assistant Secretary-Treasurer

Subscribed and sworn to before me, a Notary Public, in and for the aforesaid county and state as of this 21st day of July, 1977.

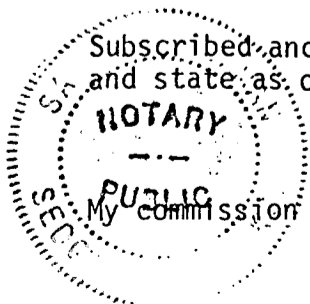

Sandra Richman  
 Sandra Richman, Notary Public