


15-063-20681-00-00

WELL PLUGGING RECORD

Give All Information Completely
 Make Required Affidavit

COUNTY Gove SEC. 15 TWP. 12S RGE. 30W E/W
 Location as in quarters or footage from lines:
C SE NW

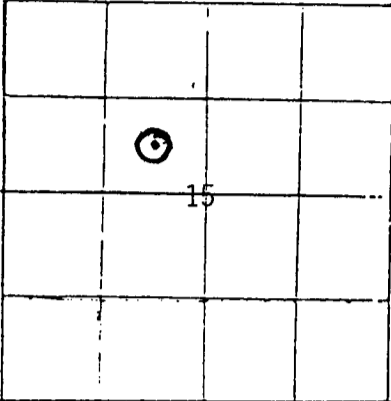

Locate Well
 correctly on above
 Section Platt.

Lease Owner Cinco Exploration Company
 Lease Name Vincent Fellhoelter Well No. 1
 Office Address P. O. Box 3723, Victoria, Texas 77903
 Character of Well (Completed as Oil, Gas or Dry Hole): Dry Hole
 Date Well Completed June 23, 1983
 Application for plugging filed June 23, 1983
 Plugging commenced June 24, 1983
 Plugging completed June 24, 1983
 Reason for abandonment of well or producing formation D & A

Was permission obtained from the Conservation Division or it's
 Agent's before plugging was commenced? Yes

Name of Conservation Agent who supervised plugging of this well Mr. Schumacker

Producing formation _____ Depth to top _____ bottom _____ T.D. 4,650'

Show depth and thickness of all water, oil and gas formations.

OIL, GAS OR WATER RECORDS Casing Record

Formation	Content	From	To	Size	Put in	Pulled Out
				8 5/8"	321.70'	-0-

Describe in detail the manner in which the well was plugged, indicating where the mud
 fluid was placed and the method or methods used in introducing it into the hold. If cement
 or other plugs were used, state the character of same and depth placed, from _____ feet
 to _____ feet for each plug set.

1st Plug @ 2319' w/20 sx cement
 2nd Plug @ 1435' w/100 sx cement
 3rd Plug @ 379' w/40 sx cement
 Bridge Plug @ 40' w/1 sx hulls & 10 sx cement
 10 sx cement in rathole
 50/50 Pozmix, 6% Gel, 3% C.C.

(If additional description is necessary, use BACK of this sheet)

Name of Plugging Contractor Halliburton Services - Oberlin, Kansas

STATE OF TEXAS COUNTY OF VICTORIA, ss.
MELVIN KLOTZMAN (employee of owner) or ~~(owner)~~ of the

above-described well, being first duly sworn on oath, says: That I have knowledge of the
 facts, statements, and matters herein contained and the log of the above-described well as
 filed and that the same are true and correct. So help me God.

STATE CORPORATION COMMISSION

07-22-1983
 JUL 22 1983

(Signature)

P. O. Box 3723 - Victoria, TX 77903
 (Address)

CONSERVATION DIVISION
 SUBSCRIBED AND SWORN TO before me this _____ day of _____, 1983

Betty Jean Davis
 Notary Public.

My Commission expires: 2/06/85