


WELL PLUGGING RECORD

Give All Information Completely  
Make Required Affidavit  
Mail or Deliver Report to:  
Conservation Division  
State Corporation Commission  
800 Bitting Building  
Wichita, Kansas

NORTH

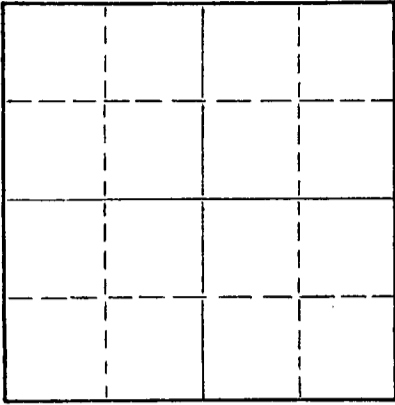

Locate well correctly on above  
Section Plat

GOVE County. Sec. 23 Twp. 12 Rge. (E) 30(W)  
Location as "NE/CNWxSWx" or footage from lines NE NE NW  
Lease Owner EMPIRE DRILLING COMPANY  
Lease Name R.J. SHAW EMPRCC Well No. 1  
Office Address 650 FOURTH NATIONAL BANK BLDG. WICHITA, KS.  
Character of Well (completed as Oil, Gas or Dry Hole) DRY HOLE  
Date well completed AUGUST 29, 1957 19  
Application for plugging filed AUGUST 29, 1957 19  
Application for plugging approved AUGUST 29, 1957 19  
Plugging commenced AUGUST 29, 1957 19  
Plugging completed AUGUST 29, 1957 19  
Reason for abandonment of well or producing formation DRY HOLE

If a producing well is abandoned, date of last production 19  
Was permission obtained from the Conservation Division or its agents before plugging was commenced? YES

Name of Conservation Agent who supervised plugging of this well FLDON PETTY  
Producing formation \_\_\_\_\_ Depth to top \_\_\_\_\_ Bottom \_\_\_\_\_ Total Depth of Well 4515 Feet  
Show depth and thickness of all water, oil and gas formations.

OIL, GAS OR WATER RECORDS

CASING RECORD

FORMATION	CONTENT	FROM	TO	SIZE	PUT IN	PULLED OUT
	SURFACE	0	209	8 5/8"	209'	0

Describe in detail the manner in which the well was plugged, indicating where the mud fluid was placed and the method or methods used in introducing it into the hole. If cement or other plugs were used, state the character of same and depth placed, from \_\_\_\_\_ feet to \_\_\_\_\_ feet for each plug set.

BOTTOM PLUG @ 200', 1/2 SACK HULLS, 20 SACKS CEMENT.  
TOP PLUG @ 40' 1/2 SACK HULLS, 10 SACKS CEMENT.

09-06-1957

(If additional description is necessary, use BACK of this sheet)

Name of Plugging Contractor EMPIRE DRILLING COMPANY  
Address 650 FOURTH NATIONAL BANK BUILDING WICHITA, KANSAS

STATE OF KANSAS, COUNTY OF SEDGWICK, ss.  
I, DAN J. KORNFELD (employee of owner or operator) of the above-described well, being first duly sworn on oath, says: That I have knowledge of the facts, statements, and matters herein contained and the log of the above-described well as filed and that the same are true and correct. So help me God.


(Signature) *Dan J. Kornfeld*

650 FOURTH NATIONAL BANK BLDG. (Address)

SUBSCRIBED AND SWORN TO before me this 5TH day of SEPTEMBER, 1957

*Hazel Pearson*  
Notary Public.

My commission expires JULY 2, 1958

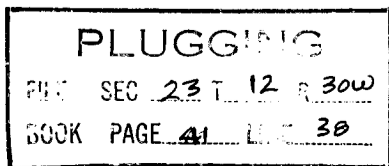

LOG

*Book*

COMPANY: EMPIRE DRILLING COMPANY  
 CONTRACTOR: EMPIRE DRILLING COMPANY  
 FARM: *Frontier Union Str*  
 LOCATION: NE NE NW SECTION 23-12-30W GOVE COUNTY, KANSAS  
 COMMENCED: AUGUST 17, 1957 ELEVATION: 2807' KB  
 COMPLETED: AUGUST 29, 1957

0	TO	226	SHALE AND SAND
226	TO	1335	SHALE AND SHELLS
1335	TO	1845	SHALE AND SAND
1845	TO	2270	SHALE AND SHELLS
2270	TO	2300	ANHYDRITE
2300	TO	2365	SHALE AND SHELLS
2365	TO	2595	SHALE
2595	TO	2920	SHALE AND SHELLS
2920	TO	3270	SHALE AND LIME
3270	TO	3380	LIME AND SHALE
3380	TO	3525	SHALE AND LIME
3525	TO	3720	SHALE AND SHELLS
3720	TO	4155	LIME
4155	TO	4230	LIME AND SHALE
4230	TO	4390	SHALE
4390	TO	4465	SHALE AND LIME
4465	TO	4515	LIME
		4515	RTD

SET: 8 5/8" 209# WITH 115 SACKS CEMENT

TOPS:	ANHYDRITE	2270
	HEEBNER	3835
	TORONTO	3863
	LANSING KC	3881
	BASE KC	4164
	MISSISSIPPIAN	4460

I, DAN J. KORNFELD, DO HEREBY CERTIFY THAT THE ABOVE AND FOREGOING IS A TRUE AND CORRECT COPY OF THE LOG ON THE SHAW NUMBER 1, NE NE NW SEC 23-12-30W, GOVE COUNTY, KANSAS AS REFLECTED BY THE FILES OF THE EMPIRE DRILLING COMPANY.

*Dan J. Kornfeld*  
DAN J. KORNFELD

WITNESSED AND SWORN TO BEFORE ME, A NOTARY PUBLIC WITHIN AND FOR SEDGWICK COUNTY, KANSAS, THIS 5TH DAY OF SEPTEMBER, 1957.

MY COMMISSION EXPIRES JULY 2, 1958

*Hazel Pierson*  
HAZEL PIERSON, NOTARY PUBLIC

PLUGGING  
 NET SEC 23 T12 R30W  
 BOOK PAGE 41 LINE 38

09-06-1957  
 CONSERVATION DIVISION  
 WICHITA, KANSAS