

STATE OF KANSAS
STATE CORPORATION COMMISSION

Form CP-4


WELL PLUGGING RECORD

Give All Information Completely
Make Required Affidavit
Mail or Deliver Report to:
Conservation Division
State Corporation Commission

P. O. Box 17027
Wichita, Kansas 67217
NORTH

Gove County, Sec. 28 Twp. 12 Rge. 30W (E) (W)

Location as "NE/CNW/SE/SW" or footage from lines C NE SW
Lease Owner Donald C. Slawson
Lease Name Schoendaler "A" Well No. 1
Office Address 408 120 Building, Wichita, Kansas 67202
Character of Well (completed as Oil, Gas or Dry Hole) Dry Hole
Date well completed November 6 1974
Application for plugging filed November 5 1974
Application for plugging approved November 5 1974
Plugging commenced November 6 1974
Plugging completed November 6 1974
Reason for abandonment of well or producing formation Dry Hole

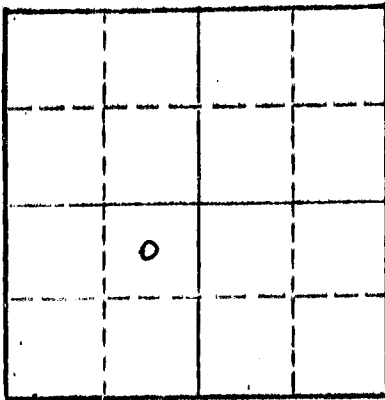

Locate well correctly on above Section Plot

If a producing well is abandoned, date of last production 19
Was permission obtained from the Conservation Division or its agents before plugging was commenced? Yes

Name of Conservation Agent who supervised plugging of this well W.L. Nichols, Morland Kansas
Producing formation Depth to top Bottom Total Depth of Well 4476 Feet
Show depth and thickness of all water, oil and gas formations.

OIL, GAS OR WATER RECORDS

CASING RECORD

FORMATION	CONTENT	FROM	TO	SIZE	PUT IN	PULLED OUT
8 5/8"	245'				253'	

Describe in detail the manner in which the well was plugged, indicating where the mud fluid was placed and the method or methods used in introducing it into the hole. If cement or other plugs were used, state the character of same and depth placed, from feet to feet for each plug set.

1st plug @ 1225' w/110 cu ft.
2nd plug @ 275' w/30 cu ft.
3rd plug @ 40' w/10 cu ft.

RECEIVED
STATE CORPORATION COMMISSION
NOV 15 1974
11-15-1974
CONSERVATION DIVISION
Wichita, Kansas

(If additional description is necessary, use BACK of this sheet)
Name of Plugging Contractor Slawson Drilling Company, Inc.
Address 408 120 Building, Wichita, Kansas 67202

STATE OF KANSAS COUNTY OF SEDGWICK
James C. Remsberg (employee of owner) or (owner or operator) of the above-described well, being first duly sworn on oath, says: That I have knowledge of the facts, statements, and matters herein contained and the log of the above-described well as filed and that the same are true and correct. So help me God.

(Signature) James C. Remsberg (Address)

Subscribed and sworn to before me this 14th day of November 1974

Dolores B. Coady Notary Public

My commission expires
DOLORES B. COADY
STATE NOTARY PUBLIC
SEDGWICK COUNTY, KANSAS
Comm. Expires Mar. 7, 1976

WELL LOG

COMPANY: Donald C. Slawson
 408 120 Buidling
 Wichita, Kansas 67202

LEASE: Schoendaler "A" #1
 C NE SW Sec. 28-12-30W
 Gove County, Kansas

TOTAL DEPTH: 4476'

CONTRACTOR: Slawson Drilling Company, Inc.

COMMENCED: October 25, 1974

COMPLETED: November 6, 1974

CASING: Set 8 5/8" @ 253' w/200 sx

0-260	Surface hole
260-340	Shale
340-2222	Shale and Sand
2222-2269	Anhydrite
2269-3985	Shale and Lime
3985-4020	Lime
4020-4047	Lime and Shale
4047-4085	Lime
4085-4385	Lime and Shale
4385-4476	Lime
4476	RTD

RECEIVED
 STATE CORPORATION COMMISSION
 NOV 15 1974
 11-15-1974
 CONSERVATION DIVISION
 Wichita, Kansas

STATE OF KANSAS)
) SS.
 COUNTY OF SEDGWICK)

I, JAMES C. REMSBERG, of the Slawson Drilling Company, Inc. upon oath state that the above and foregoing is a true and correct copy of the log of the Schoendaler "A" #1 well.

James C. Remsberg
 JAMES C. REMSBERG

Subscribed and sworn to before me this 14th day of November, 1974

Dolores B. Coady
 Dolores B. Coady, Notary Public

My Commission Expires:

DOLORES B. COADY
 STATE NOTARY PUBLIC
 SEDGWICK COUNTY, KANSAS
 Commission Expires 7, 1975