

15-179-20826-00-00

State of Kansas

NOTICE OF INTENTION TO DRILL

(see rules on reverse side)

CANCELLED
CARD MUST BE SIGNED

CARD MUST BE TYPED

Starting Date: 6-15-85
month day year

API Number 15- 179-20,826⁹⁻¹³⁻⁸⁵

OPERATOR: License # 9123
Name Diamond Shamrock Exploration Company
Address P.O. Box 400
City/State/Zip Amarillo, Texas 79188
Contact Person Todd Lovett
Phone 806-378-3848

SW SW SE Sec 2 Twp 10 S, Rge 26
(location) North
330 Ft North from Southeast Corner of Section
2970 Ft West from Southeast Corner of Section
(Note: Locate well on Section Plat on reverse side)

CONTRACTOR: License #
Name Not Available
City/State

Nearest lease or unit boundary line 330 feet.
County Sheridan
Lease Name Norbert Von Lintel Well# 6

Well Drilled For: Well Class: Type Equipment:
 Oil Swd Infield Mud Rotary
 Gas Inj Pool Ext. Air Rotary
 OWWO Expl Wildcat Cable

Domestic well within 330 feet : yes no
Municipal well within one mile : yes no

If OWWO: old well info as follows:
Operator
Well Name
Comp Date Old Total Depth
Projected Total Depth 4100 feet
Projected Formation at TD
Expected Producing Formations Lansing-Kansas City

Depth to Bottom of fresh water 200 feet
Lowest usable water formation Dakota
Depth to Bottom of usable water feet
Surface pipe by Alternate : 1 2
Surface pipe to be set 300 feet
Conductor pipe if any required feet
Ground surface elevation 2565 feet MSL
This Authorization Expires 12-1-85
Approved By 5-31-85 *R.*

I certify that we will comply with K.S.A. 55-101, et seq., plus eventually plugging hole to K.C.C. specifications.

Date 5-28-85 Signature of Operator or Agent *Patti Jones* Title Drilling & Production Clerk

MHC/HOME 5-31-85
Form C-1 4/84


Must be filed with the K.C.C. five (5) days prior to commencing well
This card void if drilling not started within six (6) months of date received by K.C.C.

RECEIVED
STATE CORPORATION COMMISSION

5-31-1985
MAY 31 1985

Important procedures to follow :

**A Regular Section of Land
1 Mile = 5,280 Ft.**

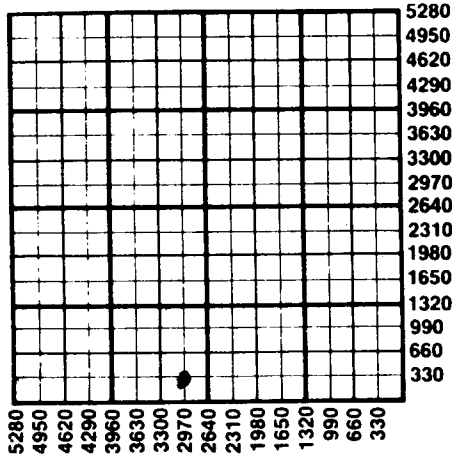

Conservation Division
Wichita, Kansas

1. Notify District office before setting surface casing.
2. Set surface casing by circulating cement to the top.
3. File completion forms ACO-1 with K.C.C. within 90 days of well completion, following instructions on ACO-1, side 1, and including copies of wireline logs.
4. Notify District office 48 hours prior to old well workover or re-entry.
5. Prior to plugging, prepare a plugging plan, then obtain agreement from the appropriate district office for an approved plugging plan.
6. Submit plugging report (CP-4) to K.C.C. after plugging is completed.
7. Obtain an approved injection docket number before disposing of salt water.
8. Notify K.C.C. within 10 days when injection commences or terminates.
9. If an alternate 2 completion, cement in the production pipe from below any usable water to surface within 120 days of spud date.

State Corporation Commission of Kansas
Conservation Division
200 Colorado Derby Building
Wichita, Kansas 67202
(316) 263-3238