

NOTICE OF INTENTION TO DRILL

- CORRECTION \*  
✓

(see rules on reverse side)

Expected Spud Date. . . . . December 10, 1987  
month day year

API Number 15-179-20,913-00-00

OPERATOR: License # 5063  
Name Energy Exploration, Inc.  
Address 1002 S. Broadway  
City/State/Zip Wichita, Ks. 67211  
Contact Person Brad D. Lehl  
Phone 316/267-7336

N/2 SW SE Sec. 2 Twp. 10 S, Rg. 26 East  
990 West  
1980 Ft. from South Line of Section  
Ft. from East Line of Section

(Note: Locate well on Section Plat on reverse side)

CONTRACTOR: License # 5107  
Name H-30 Drilling, Inc.  
City/State 251 N. Water, Suite 10, Wichita, Ks.

Nearest lease or unit boundary line 660 feet  
County Sheridan  
Lease Name Werth Well # 2

Well Drilled For: Well Class: Type Equipment:  
 Oil  Storage  Infield  Mud Rotary  
 Gas  Inj  Pool Ext.  Air Rotary  
 OWWO  Expl  Wildcat  Cable

Ground surface elevation N/A feet MSL  
Domestic well within 330 feet: \_\_\_yes  no  
Municipal well within one mile: \_\_\_yes  no

If OWWO: old well info as follows:  
Operator  
Well Name  
Comp Date Old Total Depth

Depth to bottom of fresh water. 100  
Depth to bottom of usable water 1310  
Surface pipe by Alternate: 1 \_\_\_ 2   
Surface pipe planned to be set 200'  
Conductor pipe required  
Projected Total Depth 4100 feet  
Formation Marmaton

I certify that well will comply with K.S.A. 55-101, et seq., plus eventually plugging hole to KCC specifications.  
Date 12-8-87 Signature of Operator or Agent Joseph Place (J.P.H.) Title President

For KCC Use:  
Conductor Pipe Required feet; Minimum Surface Pipe Required 200 feet per Alt.  2  
This Authorization Expires 6-7-88 Approved By J.P.H. 12-7-87 12-8-87


\* WAS 3 4620' FSL

Must be filed with the K.C.C. five (5) days prior to commencing well  
This card void if drilling not started within six (6) months of date received by K.C.C.

### Important procedures to follow:

1. Notify District office before setting surface casing.
2. Set surface casing by circulating cement to the top.
3. File completion forms ACO-1 with K.C.C. within 120 days of well spud date, following instructions on ACO-1, side 1, and including copies of wireline logs.
4. Notify District office 48 hours prior to old well workover or re-entry.
5. Prior to filing Intent, prepare a proposed plugging plan in case well is D & A, then obtain approval of plan when calling district office prior to setting surface pipe.
6. Submit plugging report (CP-4) to K.C.C. after plugging is completed.
7. Obtain an approved injection docket number before disposing of salt water.
8. Notify K.C.C. within 10 days when injection commences or terminates.
9. If an alternate 2 completion, cement in the production pipe from below any usable water to surface within 120 days of spud date.

### A Regular Section of Land 1 Mile = 5,280 Ft.

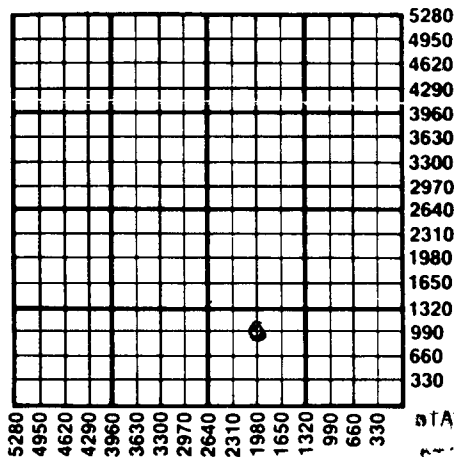

RECEIVED  
STATE CORPORATION COMMISSION  
DEC 8 1987  
12-8-1987  
CONSERVATION DIVISION  
Wichita, Kansas

State Corporation Commission of Kansas  
Conservation Division  
200 Colorado Derby Building  
Wichita, Kansas 67202-1212  
(316) 263-3238