

CARD MUST BE TYPED

State of Kansas

CARD MUST BE SIGNED

NOTICE OF INTENTION TO DRILL

RECEIVED

(see rules on reverse side)

Expected Spud Date... 12-29-87  
month day year

API Number 15-033-20, 719-0000

OPERATOR: License # 5673  
Name W. L. Kirkman  
Address P. O. Box 782290  
City/State/Zip Wichita, KS 67278-2290  
Contact Person Wayne Kirkman  
Phone 316-685-5372

150'E C-E/2 SE Sec. 10 Twp. 35 S, Rg. 20  East  West  
1320 Ft. from South Line of Section  
510 Ft. from East Line of Section

(Note: Locate well on Section Plat on reverse side)

CONTRACTOR: License # 5107  
Name H-30, Inc.  
City/State Wichita, KS

Nearest lease or unit boundary line 510 feet  
County Comanche  
Lease Name Box Ranch B Well # 2  
Ground surface elevation 1740 feet MSL  
Domestic well within 330 feet: \_\_\_yes no  
Municipal well within one mile: \_\_\_yes no  
Depth to bottom of fresh water.....  
Depth to bottom of usable water 200.....  
Surface pipe by Alternate: 1  2 \_\_\_  
Surface pipe planned to be set 600.....  
Conductor pipe required.....  
Projected Total Depth 5700..... feet  
Formation Morrow Sand.....

Well Drilled For: Well Class: Type Equipment:  
\_\_\_ Oil \_\_\_ Storage \_\_\_ Infield  Mud Rotary  
 Gas \_\_\_ Inj  Pool Ext. \_\_\_ Air Rotary  
\_\_\_ OWWO \_\_\_ Expl \_\_\_ Wildcat \_\_\_ Cable

If OWWO: old well info as follows:

Operator.....  
Well Name.....  
Comp Date..... Old Total Depth.....

I certify that well will comply with K.S.A. 55-101, et seq., plus eventually plugging hole to KCC specifications.

Date 12-29-87 Signature of Operator or Agent Title.....

For KCC Use:

Conductor Pipe Required..... feet; Minimum Surface Pipe Required 250 feet per Alt. (1)   
This Authorization Expires 6-29-88 Approved By [Signature] 12-29-87


EXPIRES DATE: 1-3-88

Must be filed with the K.C.C. five (5) days prior to commencing well  
This card void if drilling not started within six (6) months of date received by K.C.C.

### Important procedures to follow:

1. Notify District office before setting surface casing.
2. Set surface casing by circulating cement to the top.
3. File completion forms ACO-1 with K.C.C. within 120 days of well spud date, following instructions on ACO-1, side 1, and including copies of wireline logs.
4. Notify District office 48 hours prior to old well workover or re-entry.
5. Prior to filing Intent, prepare a proposed plugging plan in case well is D & A, then obtain approval of plan when calling district office prior to setting surface pipe.
6. Submit plugging report (CP-4) to K.C.C. after plugging is completed.
7. Obtain an approved injection docket number before disposing of salt water.
8. Notify K.C.C. within 10 days when injection commences or terminates.
9. If an alternate 2 completion, cement in the production pipe from below any usable water to surface within 120 days of spud date.

### A Regular Section of Land 1 Mile = 5,280 Ft.

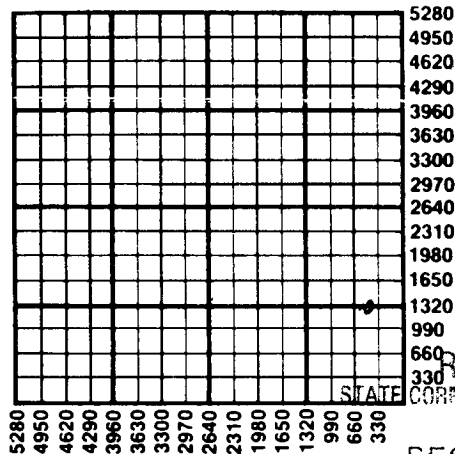

RECEIVED  
STATE CORPORATION COMMISSION

DEC 29 1987

CONSERVATION DIVISION  
Wichita, Kansas

State Corporation Commission of Kansas  
Conservation Division  
200 Colorado Derby Building  
Wichita, Kansas 67202-1212  
(316) 263-3238