

NOTICE OF INTENTION TO DRILL

(see rules on reverse side)

Starting Date JUNE 1, 1987 month day year

API Number 15-033-20, 708-0000 ✓

OPERATOR: License # 4145 Name Roberts and Murphy, Inc. Address 1500 N. Market City/State/Zip Shreveport, LA 71107 Contact Person Brad Cummings Phone (318) 221-8601

SW NE SW Sec. 11 Twp 35 S, Rg. 20 XX West 1700' Ft. from South Line of Section 3575' Ft. from East Line of Section

(Note: Locate well on Section Plat on reverse side)

Nearest lease or unit boundary line 1700' feet County Comanche Lease Name Box Ranch Well # 2-11

CONTRACTOR: License # 5654 Name Rine Drilling Co. City/State Wichita, Kansas

Ground surface elevation feet MSL Domestic well within 330 feet: yes no Municipal well within one mile: yes no

Well Drilled For: Well Class: Type Equipment: Oil SWD Infield Mud Rotary Gas Inj Pool Ext Air Rotary OWWO Expl Wildcat Cable

Depth to bottom of fresh water 40' Depth to bottom of usable water 200 Surface pipe by Alternate: 1 & 2 Surface pipe planned to be set 850' Conductor pipe required 80' Projected Total Depth 5950' feet Formation Mississippian

If OWWO: old well info as follows:

Operator Well Name Comp Date Old Total Depth

I certify that well will comply with K.S.A. 55-101, et seq., plus eventually plugging hole to KCC specifications.

Date 5/26/87 Signature of Operator or Agent Brad Cummings Title LANDMAN

For KCC Use:


Conductor Pipe Required feet; Minimum Surface Pipe Required 200 feet per Alt. This Authorization Expires 11-28-87 Approved By 5-28-87

Must be filed with the K.C.C. five (5) days prior to commencing well
 This card void if drilling not started within six (6) months of date received by K.C.C.

Important procedures to follow:

1. Notify District office before setting surface casing.
 2. Set surface casing by circulating cement to the top.
 3. File completion forms ACO-1 with K.C.C. within 90 days of well completion, following instructions on ACO-1, side 1, and including copies of wireline logs.
 4. Notify District office 48 hours prior to old well workover or re-entry.
4. Prior to filing Intent, prepare a proposed plugging plan in case well is D & A, then obtain approval of plan when calling district office prior to setting surface pipe.
5. Submit plugging report (CP-4) to K.C.C. after plugging is completed.
6. Obtain an approved injection docket number before disposing of salt water.
8. Notify K.C.C. within 10 days when injection commences or terminates.
 9. If an alternate 2 completion, cement in the production pipe from below any usable water to surface within 120 days of spud date.

A Regular Section of Land
 1 Mile = 5,280 Ft.

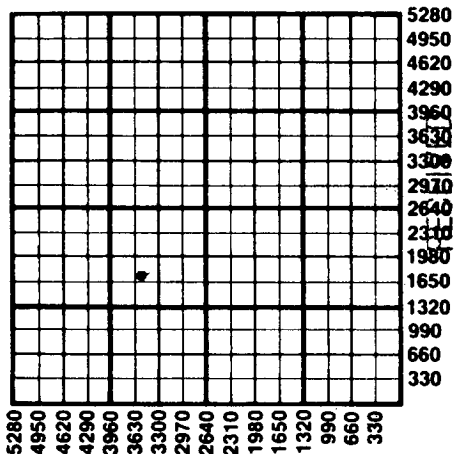

STATE CORPORATION COMMISSION

S-28-87
 MAY 28 1987

CONSERVATION DIVISION,
 Wichita, Kansas

State Corporation Commission of Kansas
 Conservation Division
 200 Colorado Derby Building
 Wichita, Kansas 67202
 (316) 263-3238